


T.12S., R.6W., W.M.

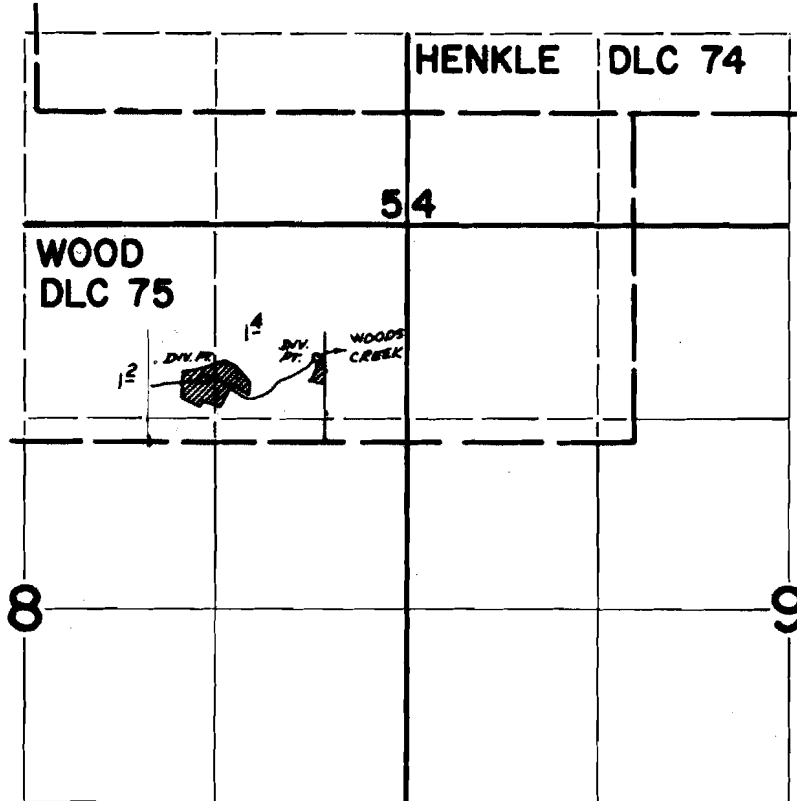

DIV. PTS. LOCATED: 430' N & 2970' W; 500' N & 2190' W, BOTH FROM SE COR WOOD DLC 75.

FINAL PROOF SURVEY UNDER

Application No. 47230 Permit No. 35380
IN NAME OF

ETHEL MAY SLACK

Surveyed Sept. 24 1974, by D. J. [Signature]