


T.12S. R.6W. W.M.

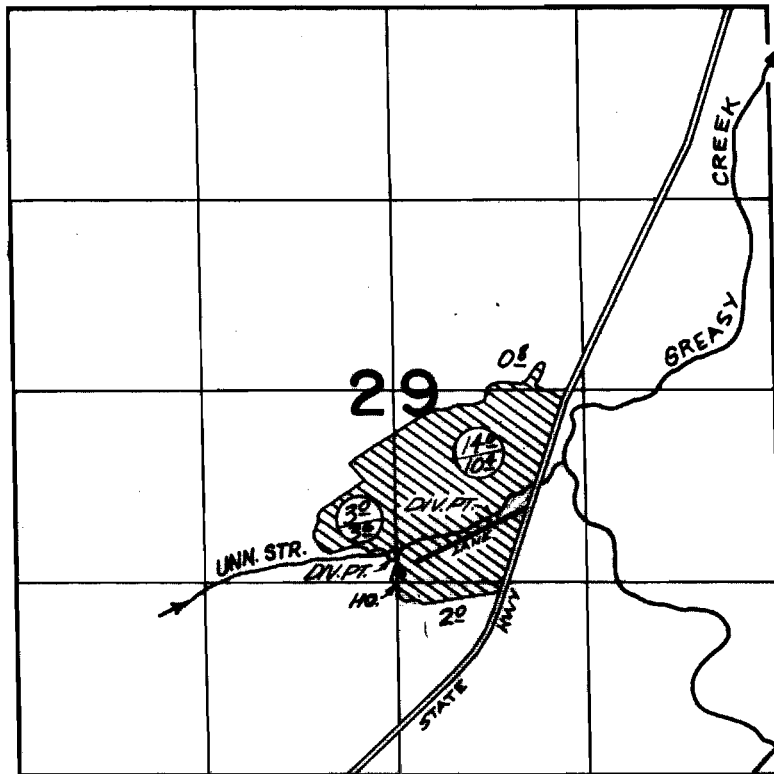

EXISTING RIGHTS

PERMIT 35950

DIV. PTS. LOCATED; DOMESTIC - 1500' N. & 20' W., IRRIGATION  
1750' N. & 680' E., BOTH FROM S  $\frac{1}{4}$  COR. SEC. 29.

**FINAL PROOF SURVEY**  
UNDER

Application No. 47951 Permit No. 35950  
IN NAME OF

WILLIAM ARCHIE STURDEVANT

Surveyed NOV. 7 1974, by W.M. TOLL