


T. 12 S. R. 6 W. W.M.

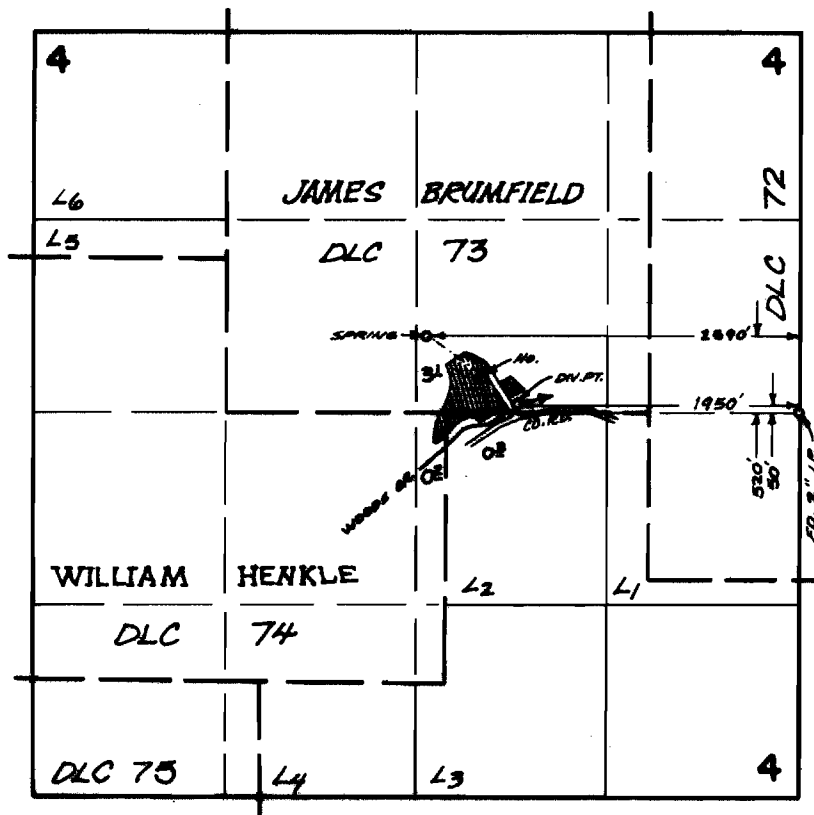

FINAL PROOF SURVEY UNDER

Application No. 48867 Permit No. 36615
IN NAME OF

LIPMAN WONG

Surveyed NOV. 5 1974, by L.M. TOLL