


T.5 N., R.7 W., W.M.

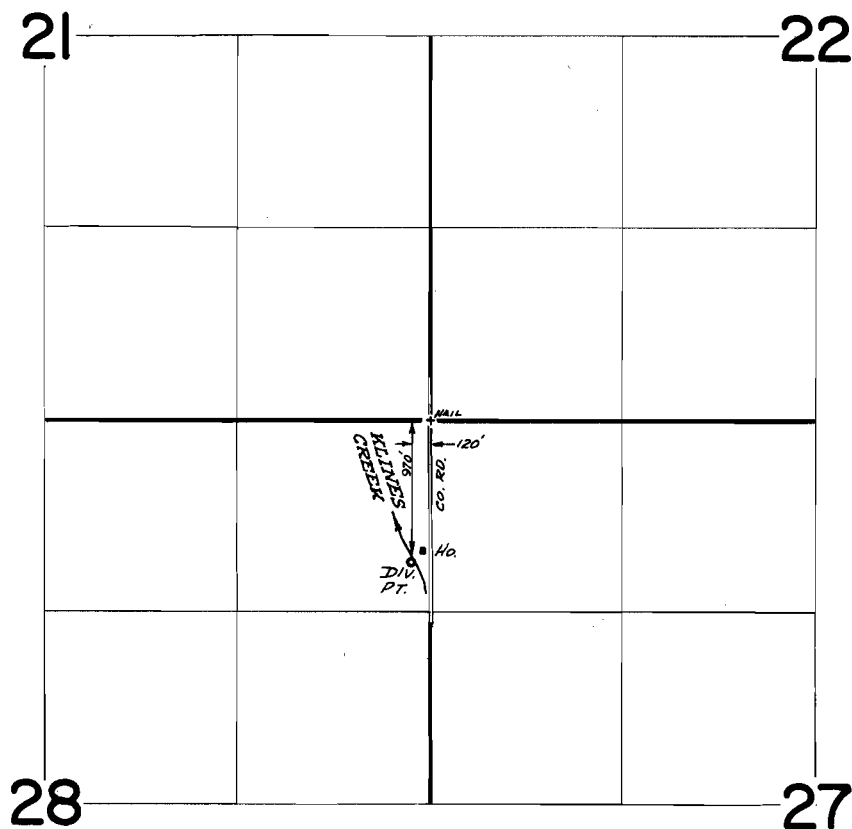

FINAL PROOF SURVEY
UNDER

Application No. 43987 Permit No. 32884
IN NAME OF

JOHN AND HELENA REIERSON

Surveyed June 6 1974, by D. Norby