


T.8N., R.7W., W.M.

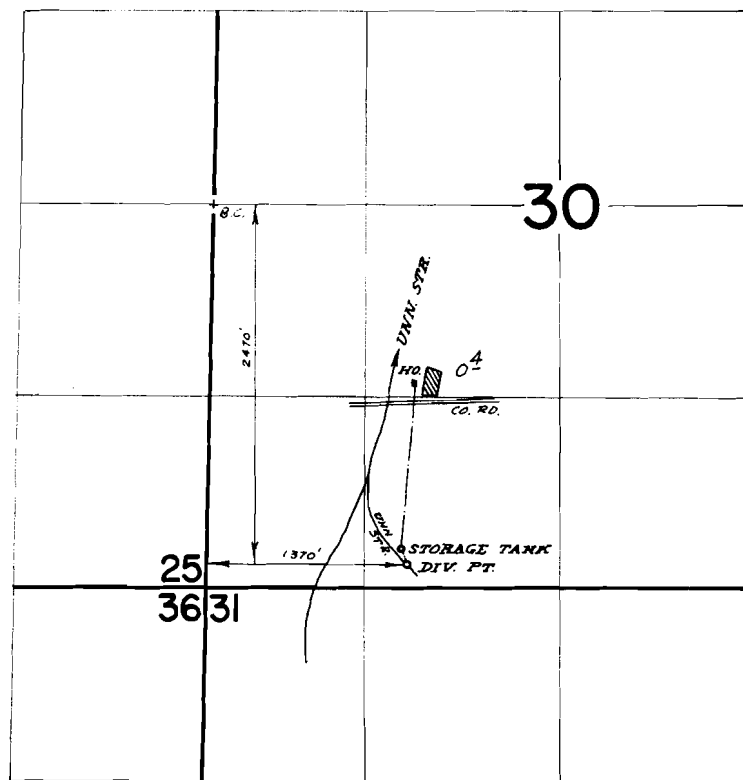

FINAL PROOF SURVEY
UNDER

Application No. 47248 Permit No. 35259
IN NAME OF

PETER L. LARSON

Surveyed June 3 1974, by D. Norby