


T.3 N. R.2 W. W.M.

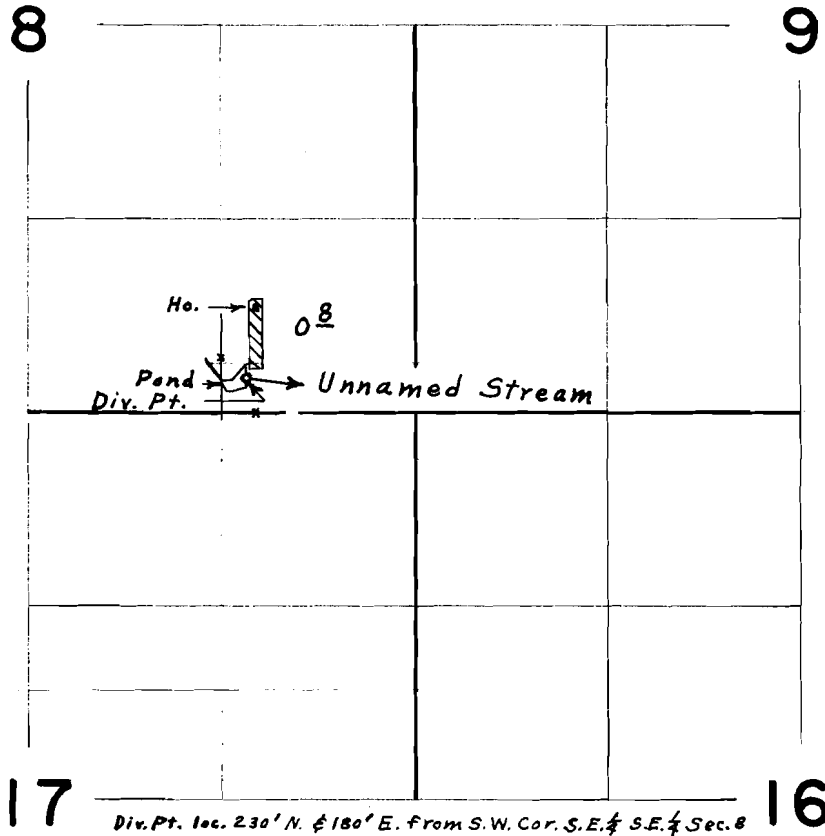

Application No. *R 54708, 54709*
Permit No. *R 6540, 40999*

FINAL PROOF SURVEY
UNDER

Application No. 38362 Permit No. 28589
IN NAME OF

KENNETH A. & DONNA D. SLOCUM

Surveyed June 26, 1974, by L. E. Gould