


T. 7 N. R. 4 W. W. M.

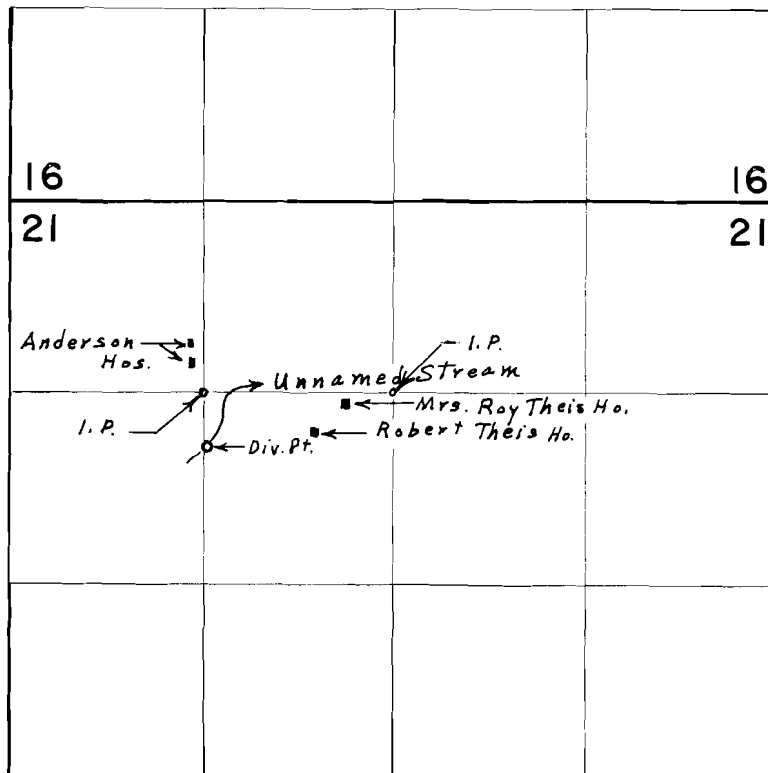

Div. Pt. loc. 380' S' & 20' E. from S. W. Cor. N. E. & N. W. Sec. 21

**FINAL PROOF SURVEY**  
UNDER

Application No. 45157 Permit No. 33286  
IN NAME OF  
ERIC F. ANDERSON  
ESTATE OF ROY H. THEIS & ROBERT R. THEIS

Surveyed July 12, 1973, by L. E. Gould