


T.38 S. R.14 W. W.M.

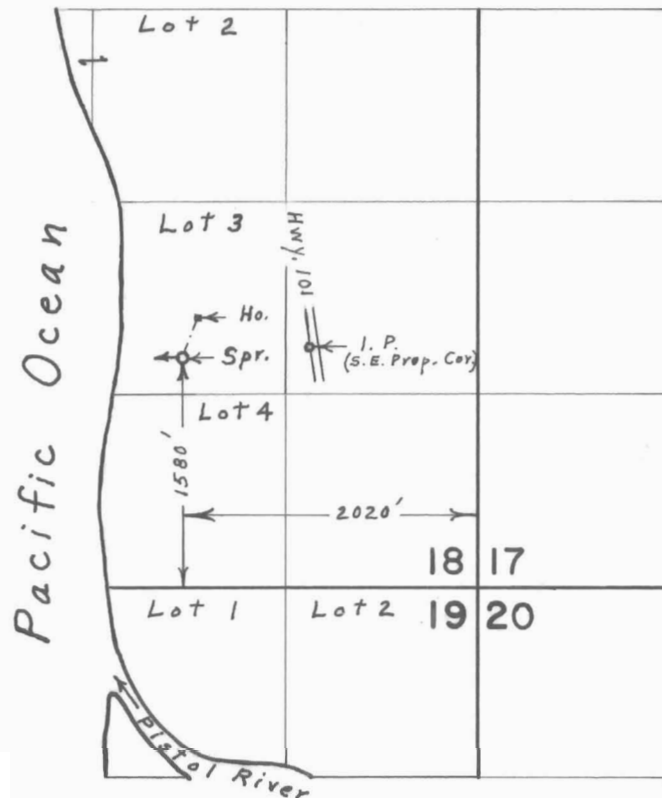

FINAL PROOF SURVEY
UNDER

Application No. 49650 Permit No. 37178
IN NAME OF

WILBUR R. & BERTHA RILEY

Surveyed Aug. 29, 1974, by L. E. Gould