
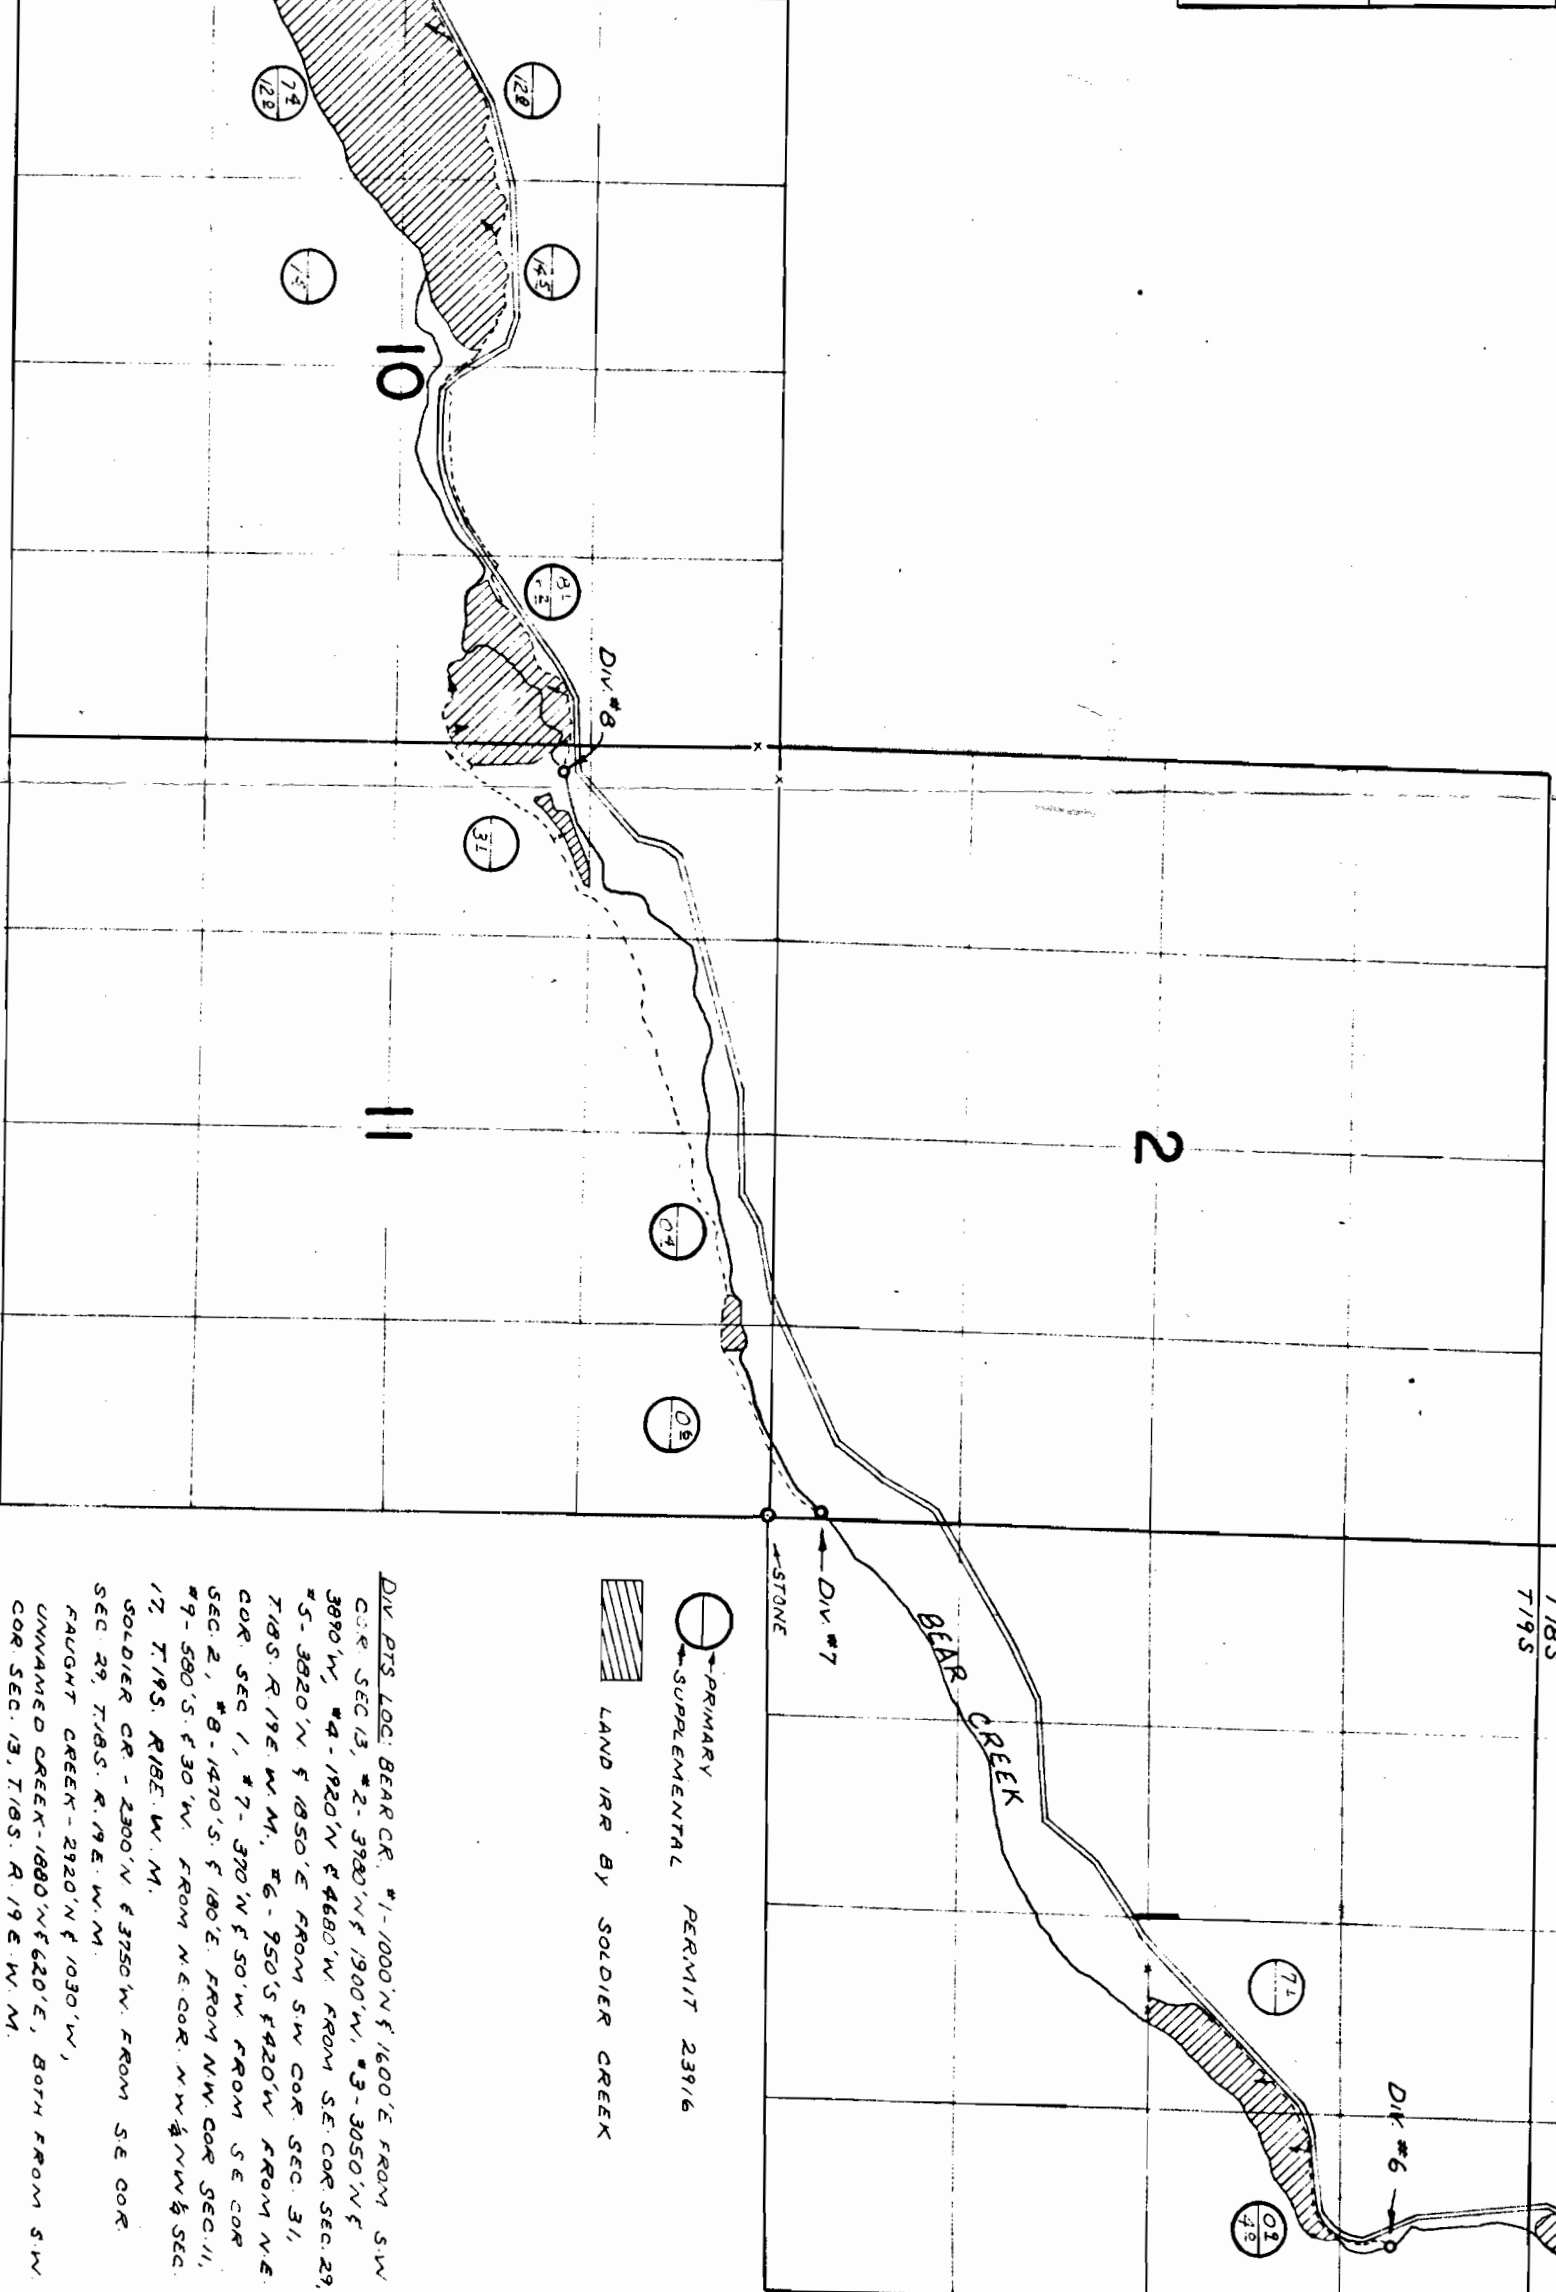







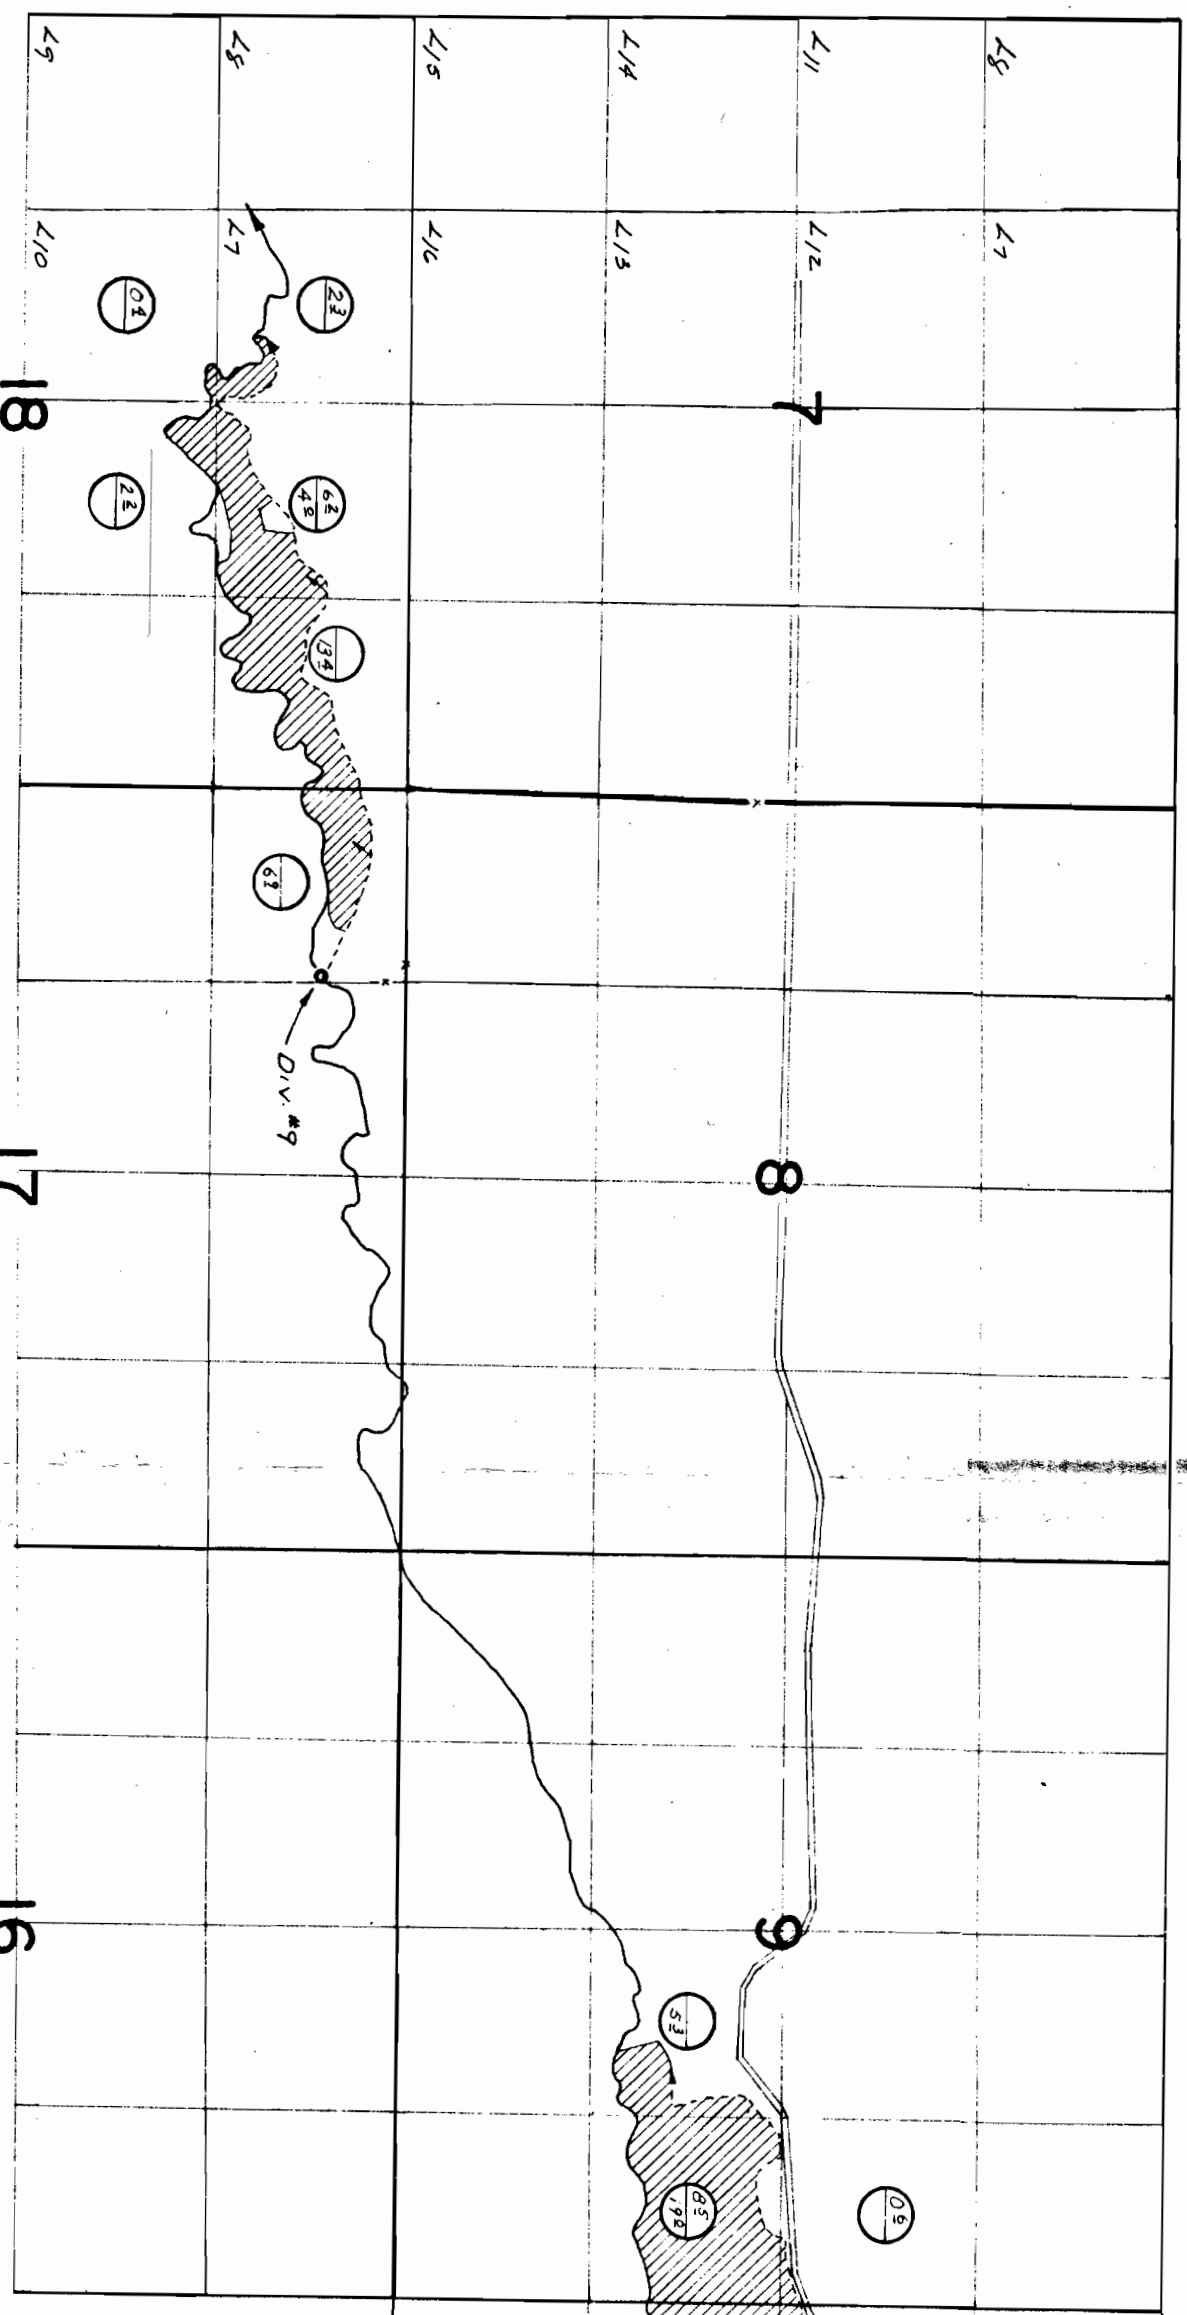

APPLICATION NO. R-25608 PERMIT NO. R-1805

IN NAME OF

SURVEYED JUNE 25-26, 1974 BY R. MUCKEN