

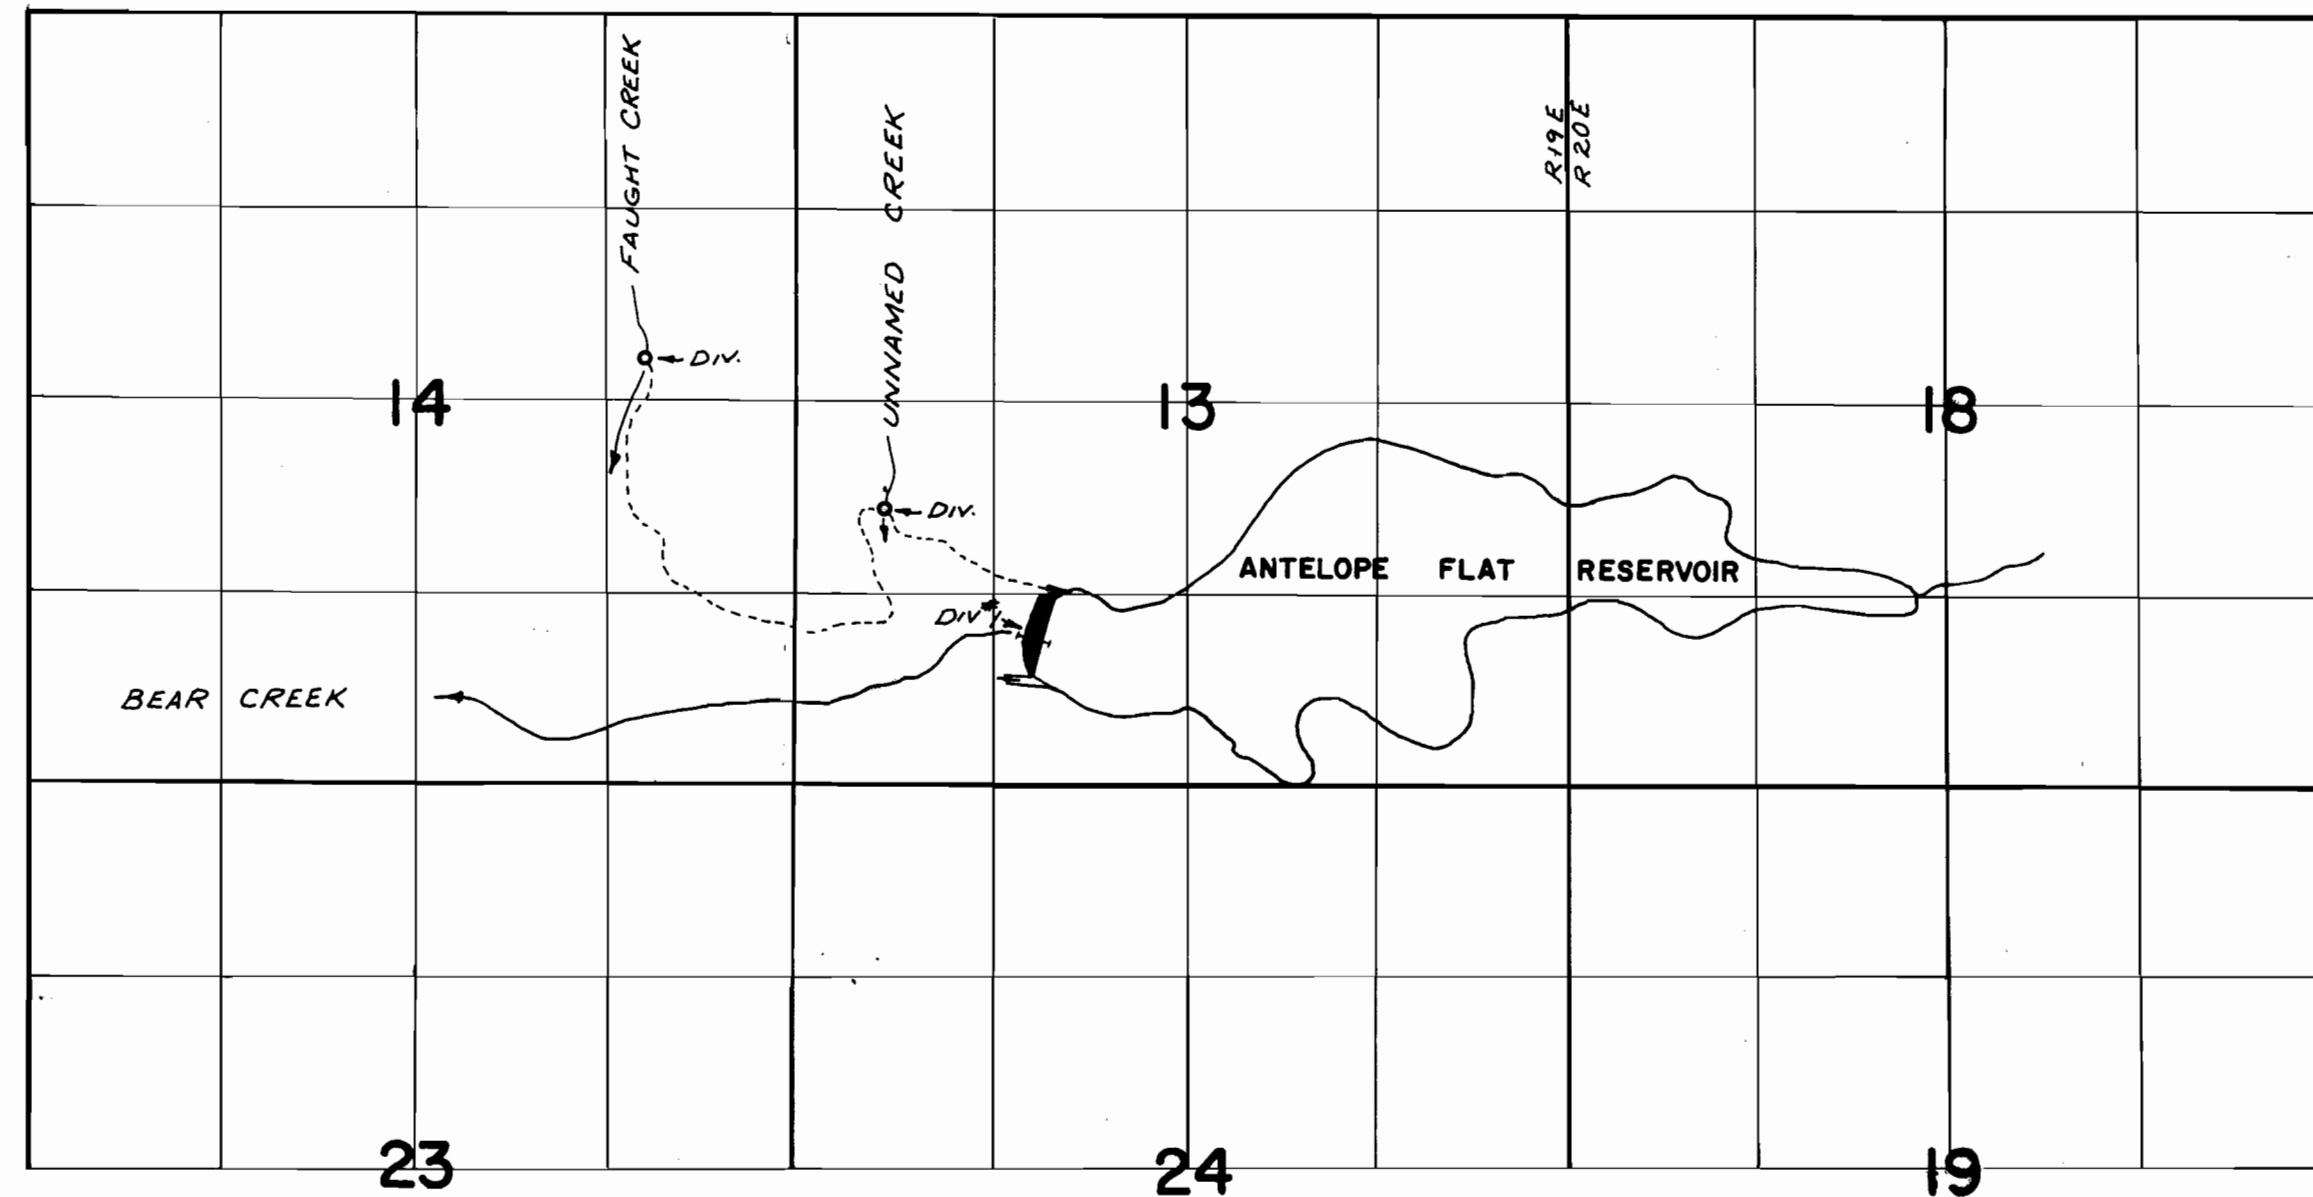


T.18S.R.19&20E.W.M.

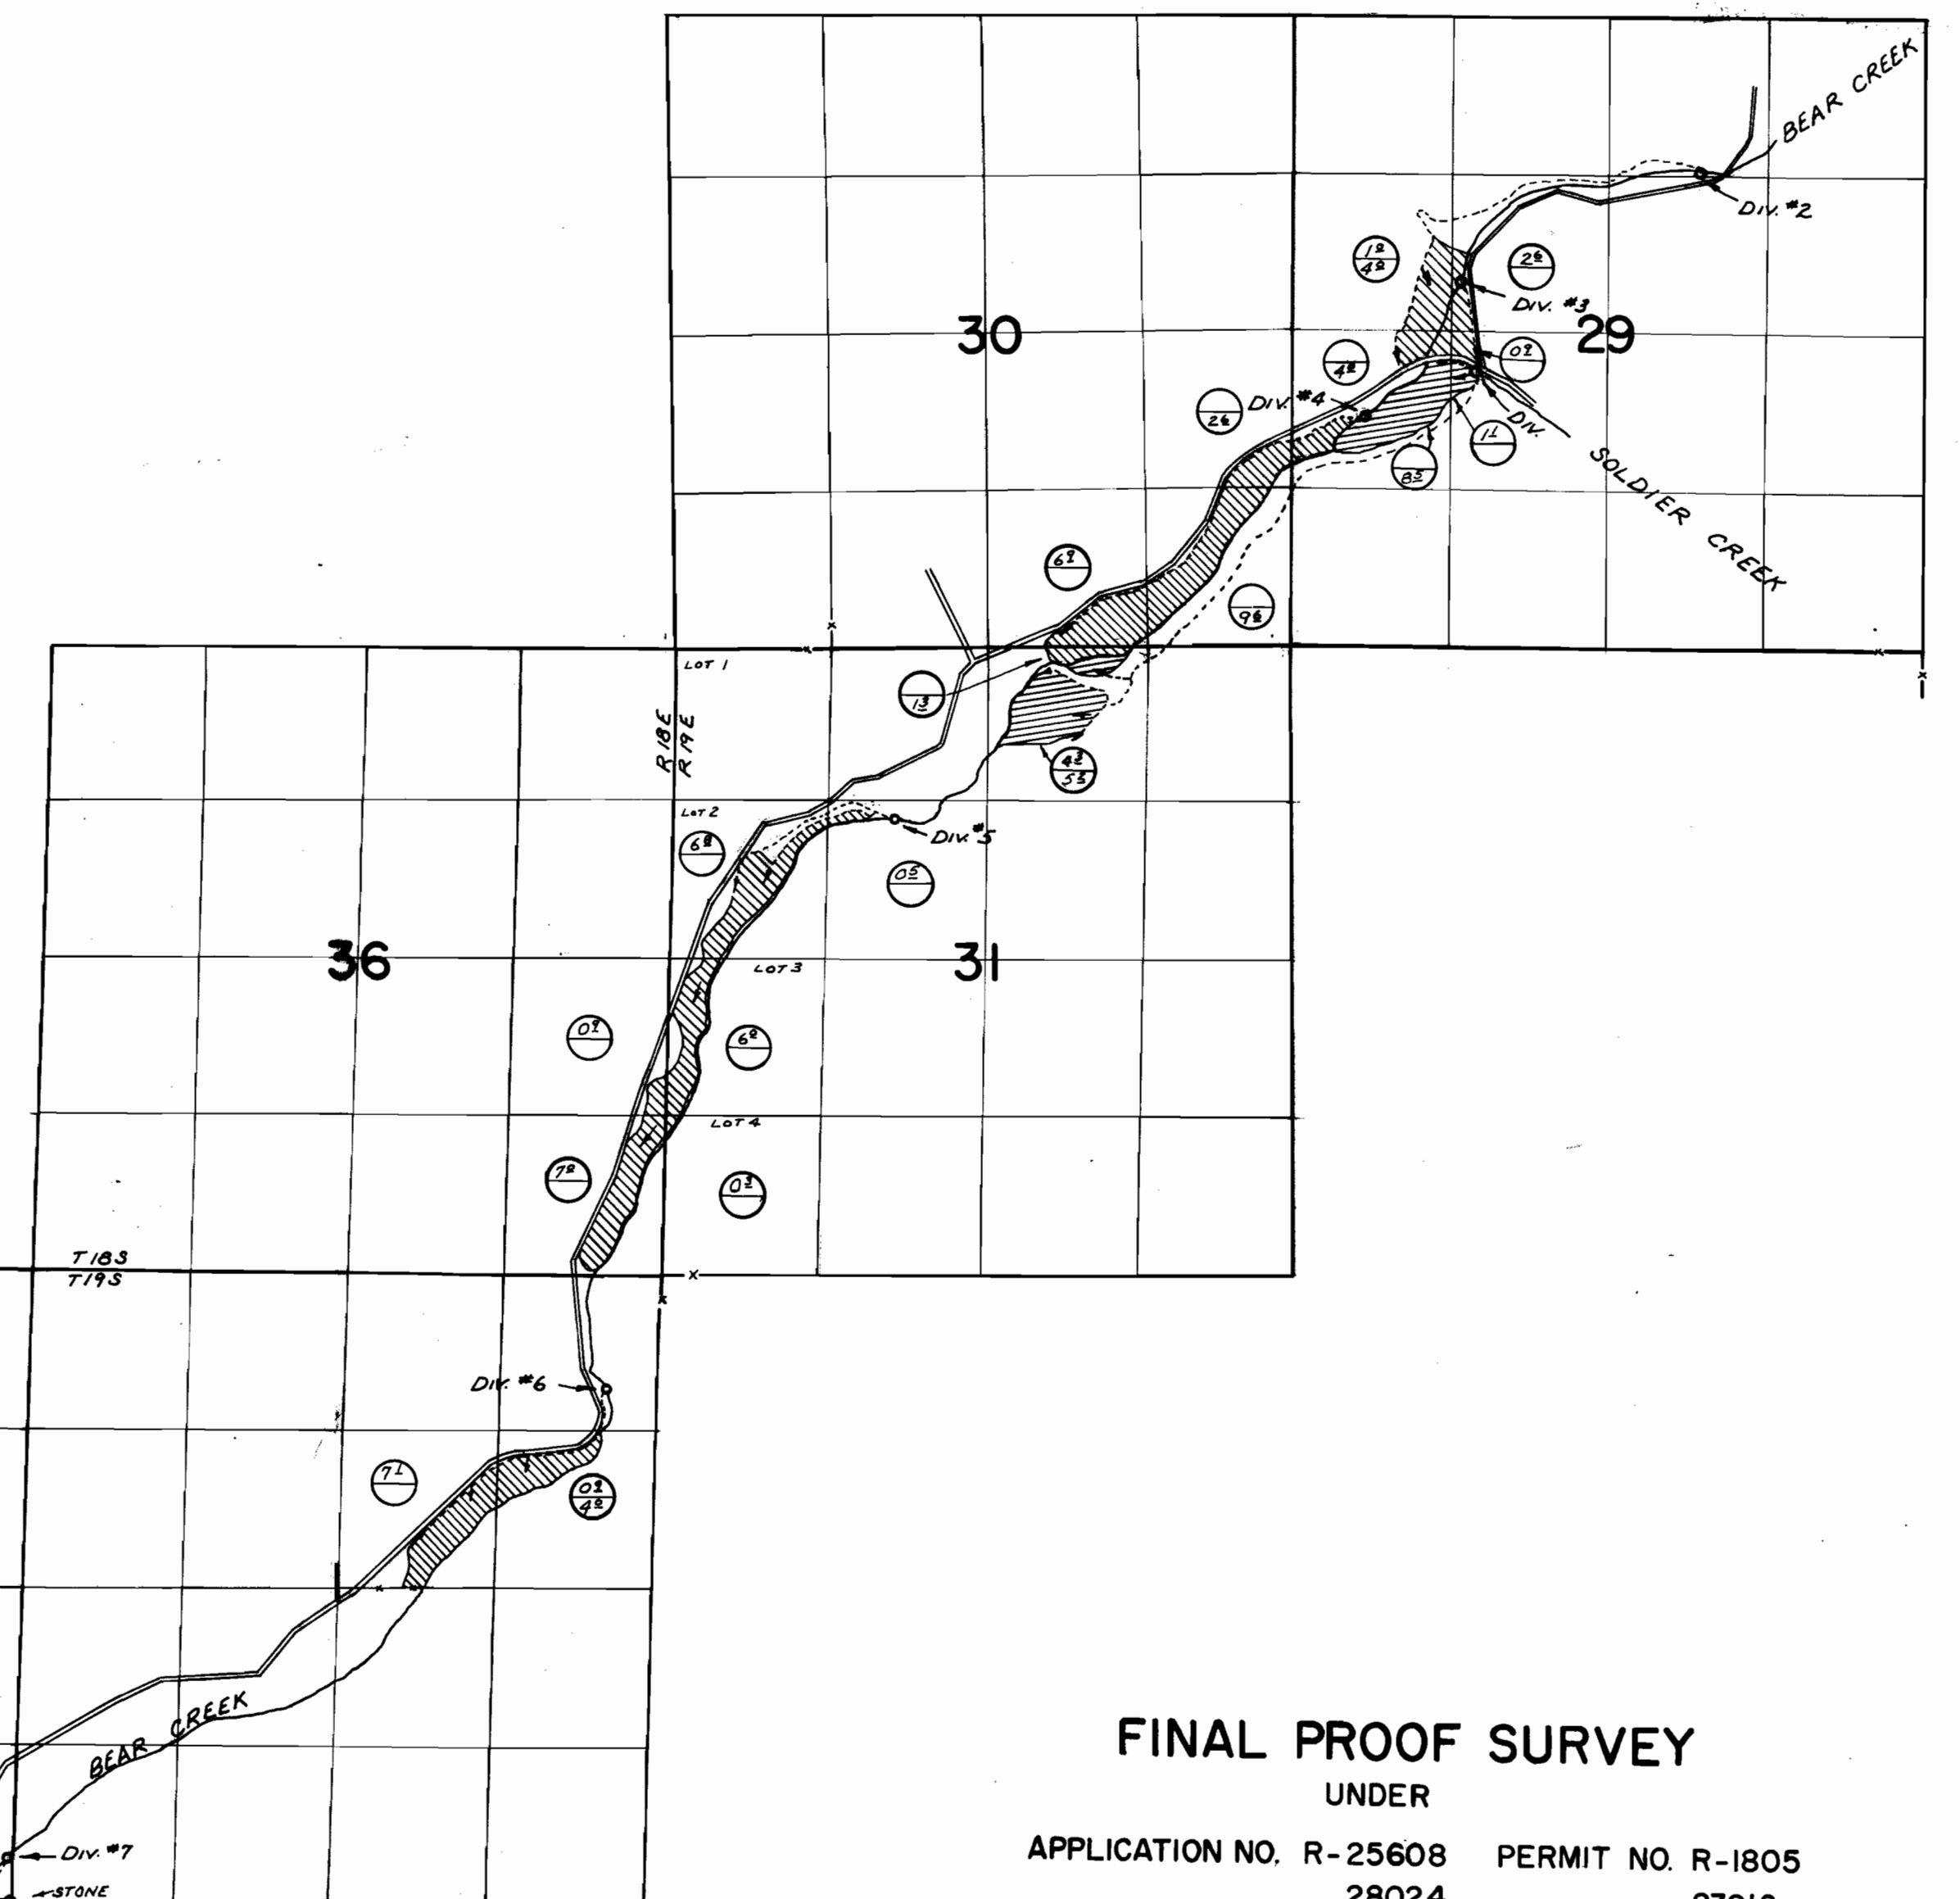

T.18 & 19S.R.18&19E.W.M.

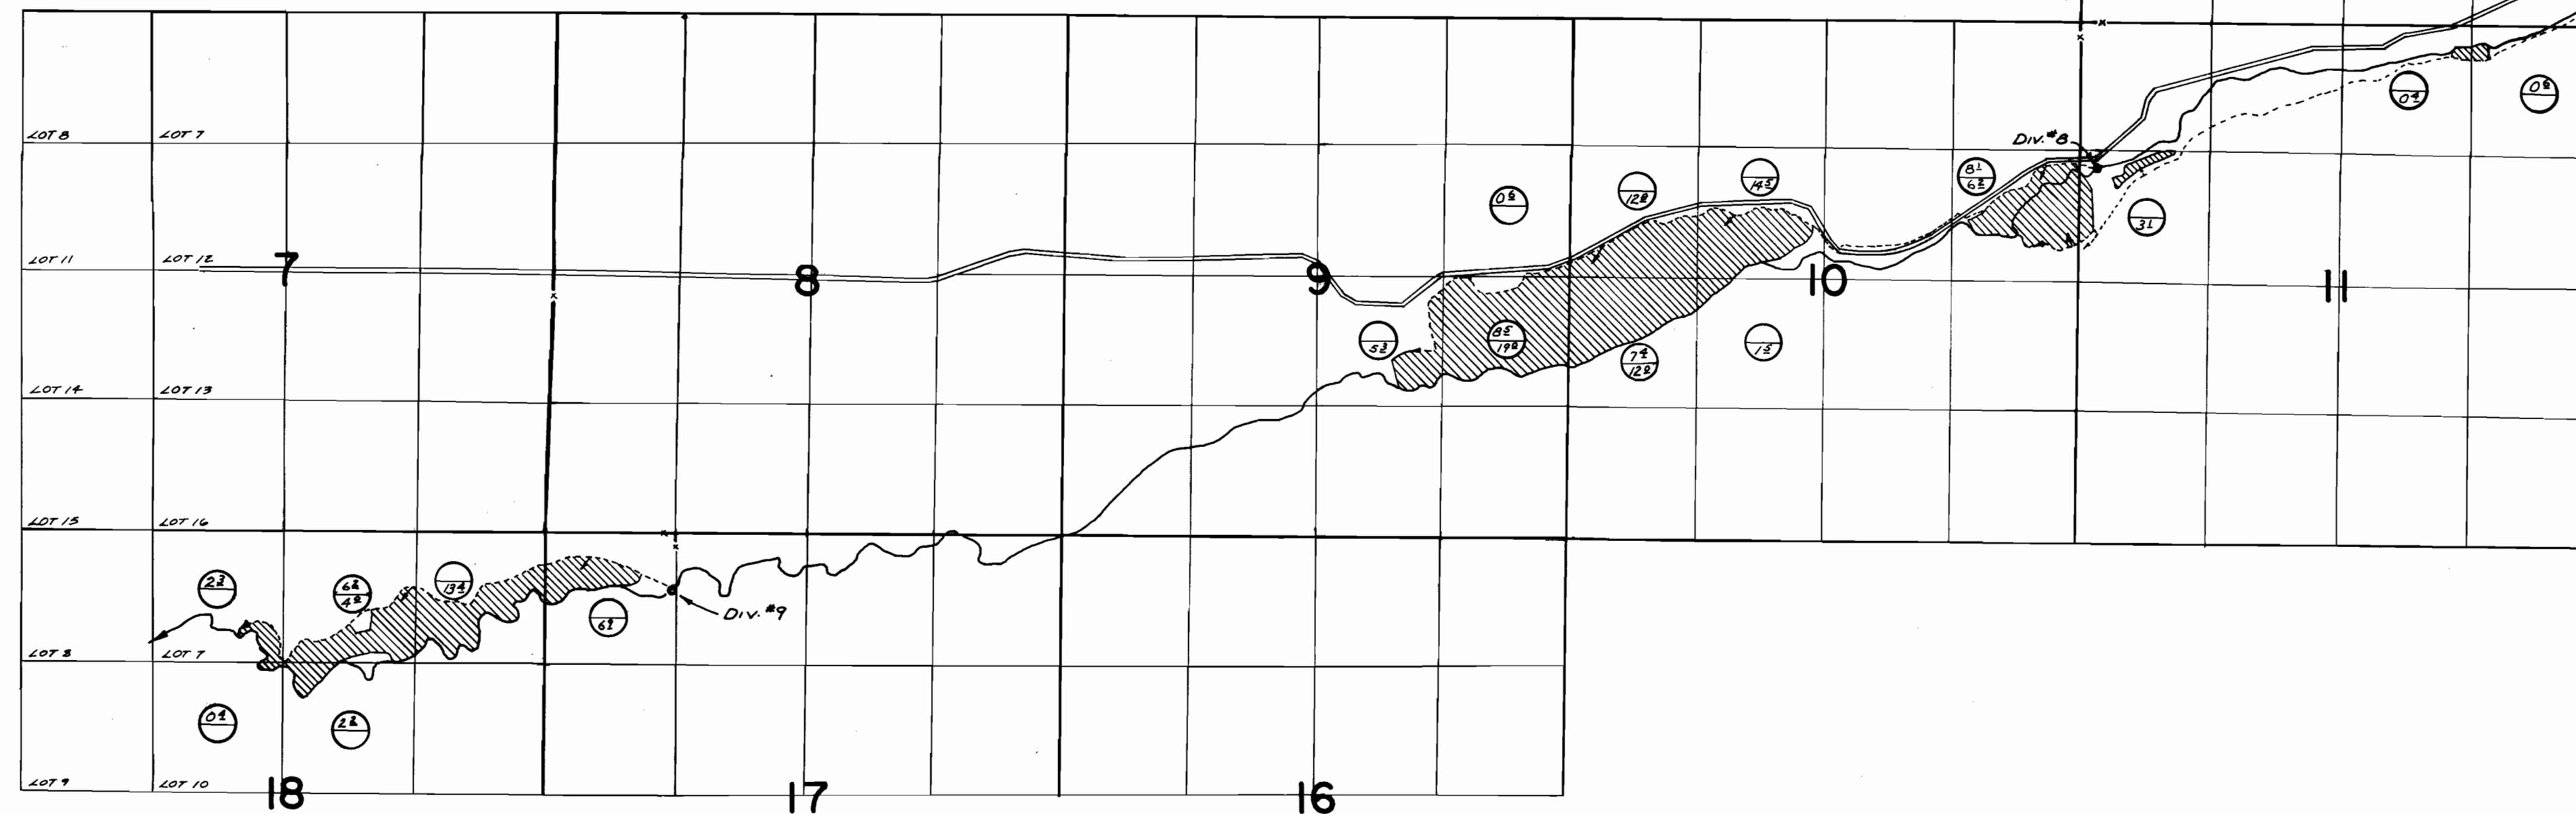

FINAL PROOF SURVEY

UNDER

APPLICATION NO. R-25608	PERMIT NO. R-1805
28024	23916
R-30697	R-1915
30698	24428
R-34948	R-2657
34949	27526

IN NAME OF

WILLIAM R. McCORMACK

SURVEYED JUNE 25-26, 1974 BY R. MUCKEN

○ PRIMARY
 ● SUPPLEMENTAL
 PERMIT 23916
 LAND IRR BY SOLDIER CREEK

DIV. PTS. LOC. BEAR CR. #1-1000' N 1600' E FROM S.W. COR. SEC. 13, #2-3700' N 1300' W, #3-3050' N 380' W, #4-1920' N 4450' W FROM S.E. COR. SEC. 29, #5-3820' N 1850' E FROM S.W. COR. SEC. 31, T.18S. R.19E. W.M., #6-750' S 4420' W FROM N.E. COR. SEC. 1, #7-370' N 50' W FROM S.E. COR. SEC. 2, #8-1470' S 180' E FROM N.W. COR. SEC. 11, #9-500' S 130' W FROM N.E. COR. N.W. & N.W. SEC. 17, T.19S. R.19E. W.M.
 SOLDIER CR. - 2300' N 13750' W FROM S.E. COR. SEC. 29, T.18S. R.19E. W.M.
 FAUGHT CREEK - 2720' N 1030' W, UNNAMED CREEK - 1880' N 1620' E, BOTH FROM S.W. COR. SEC. 13, T.18S. R.19E. W.M.