

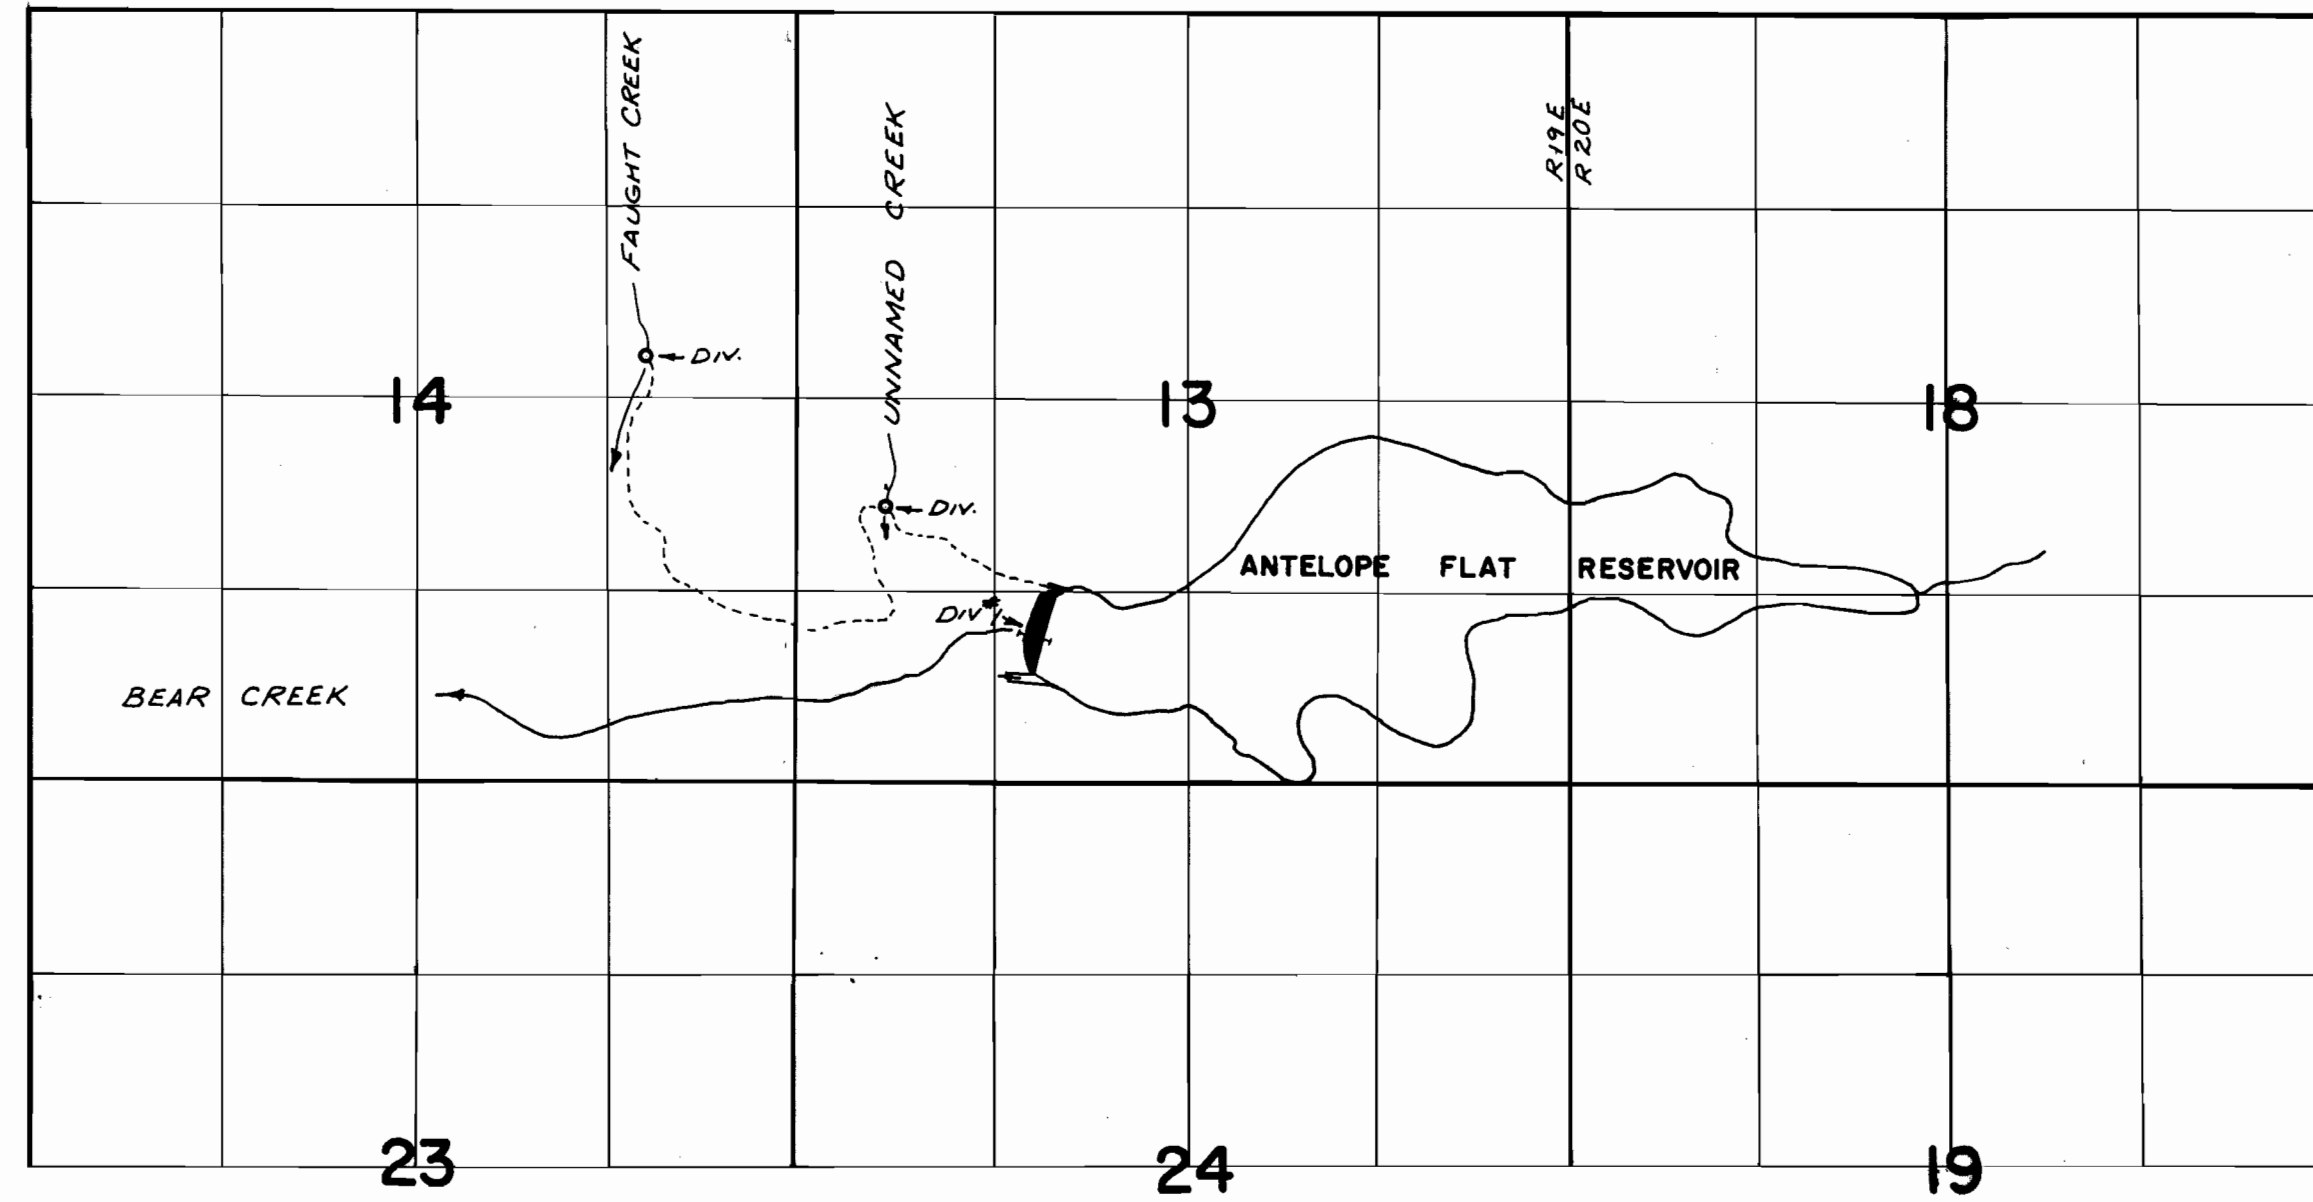


T.18S.R.19&20E.W.M.

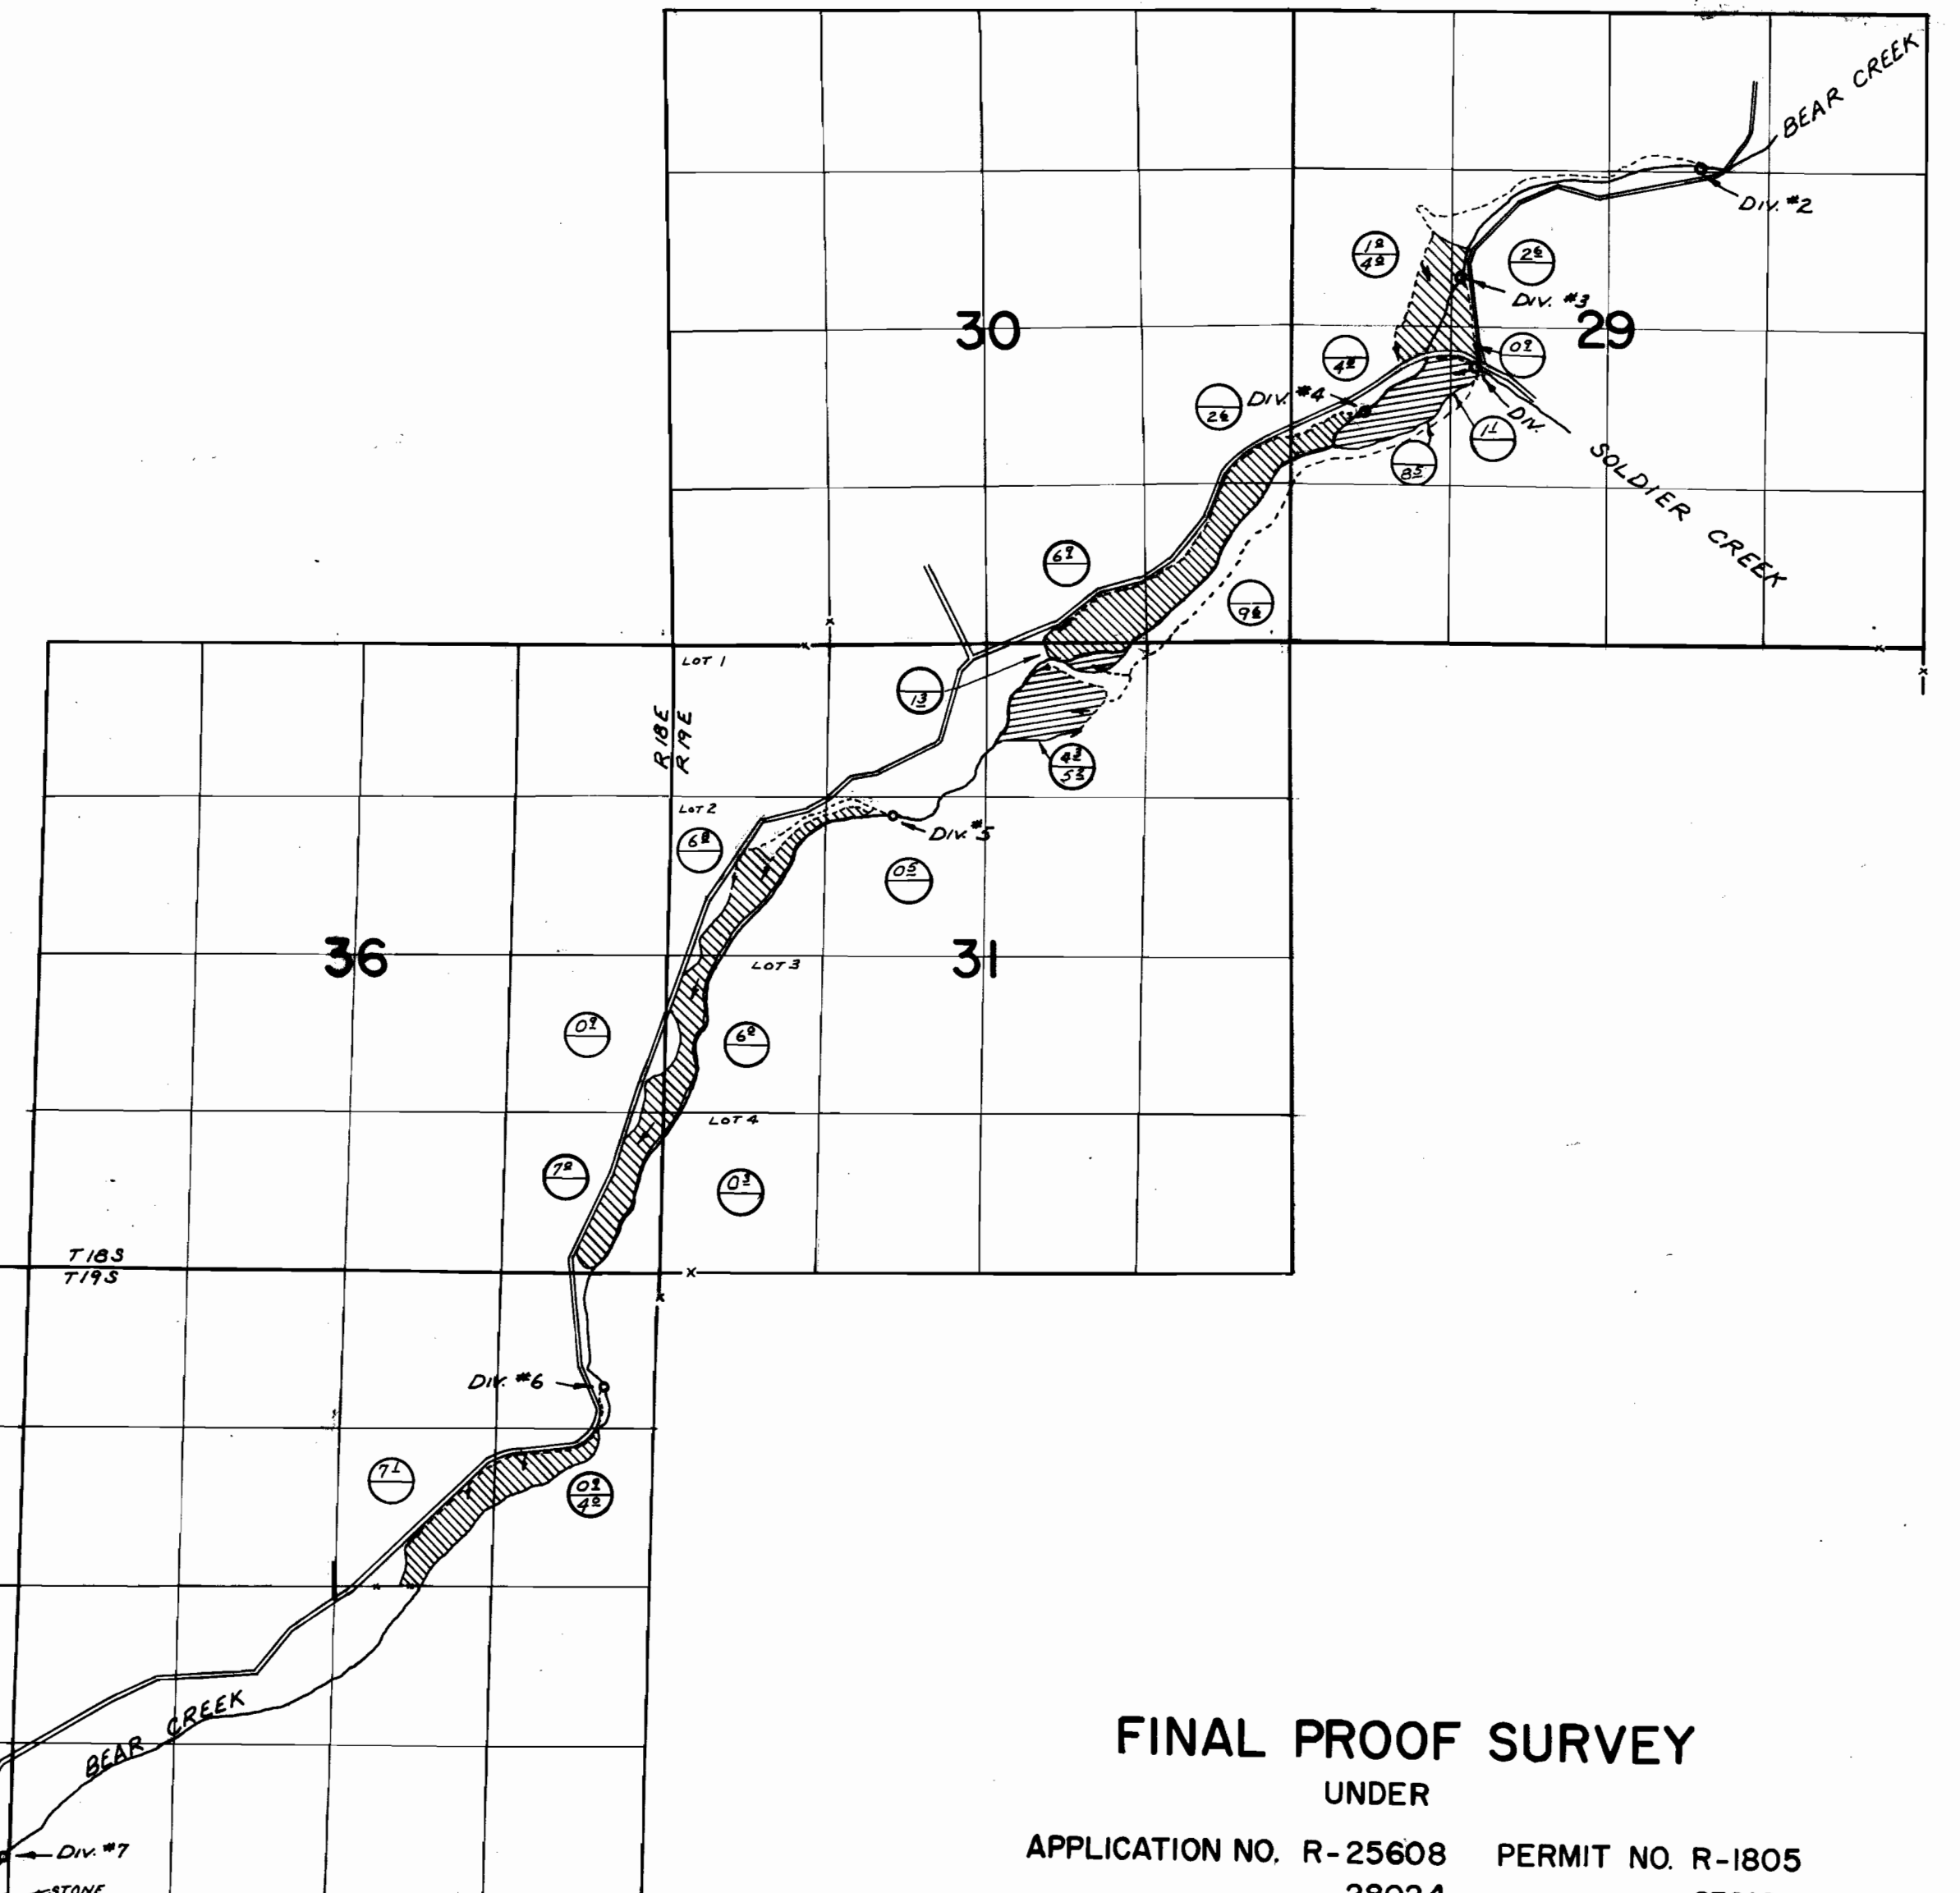

T.18 & 19 S.R.18&19E.W.M.

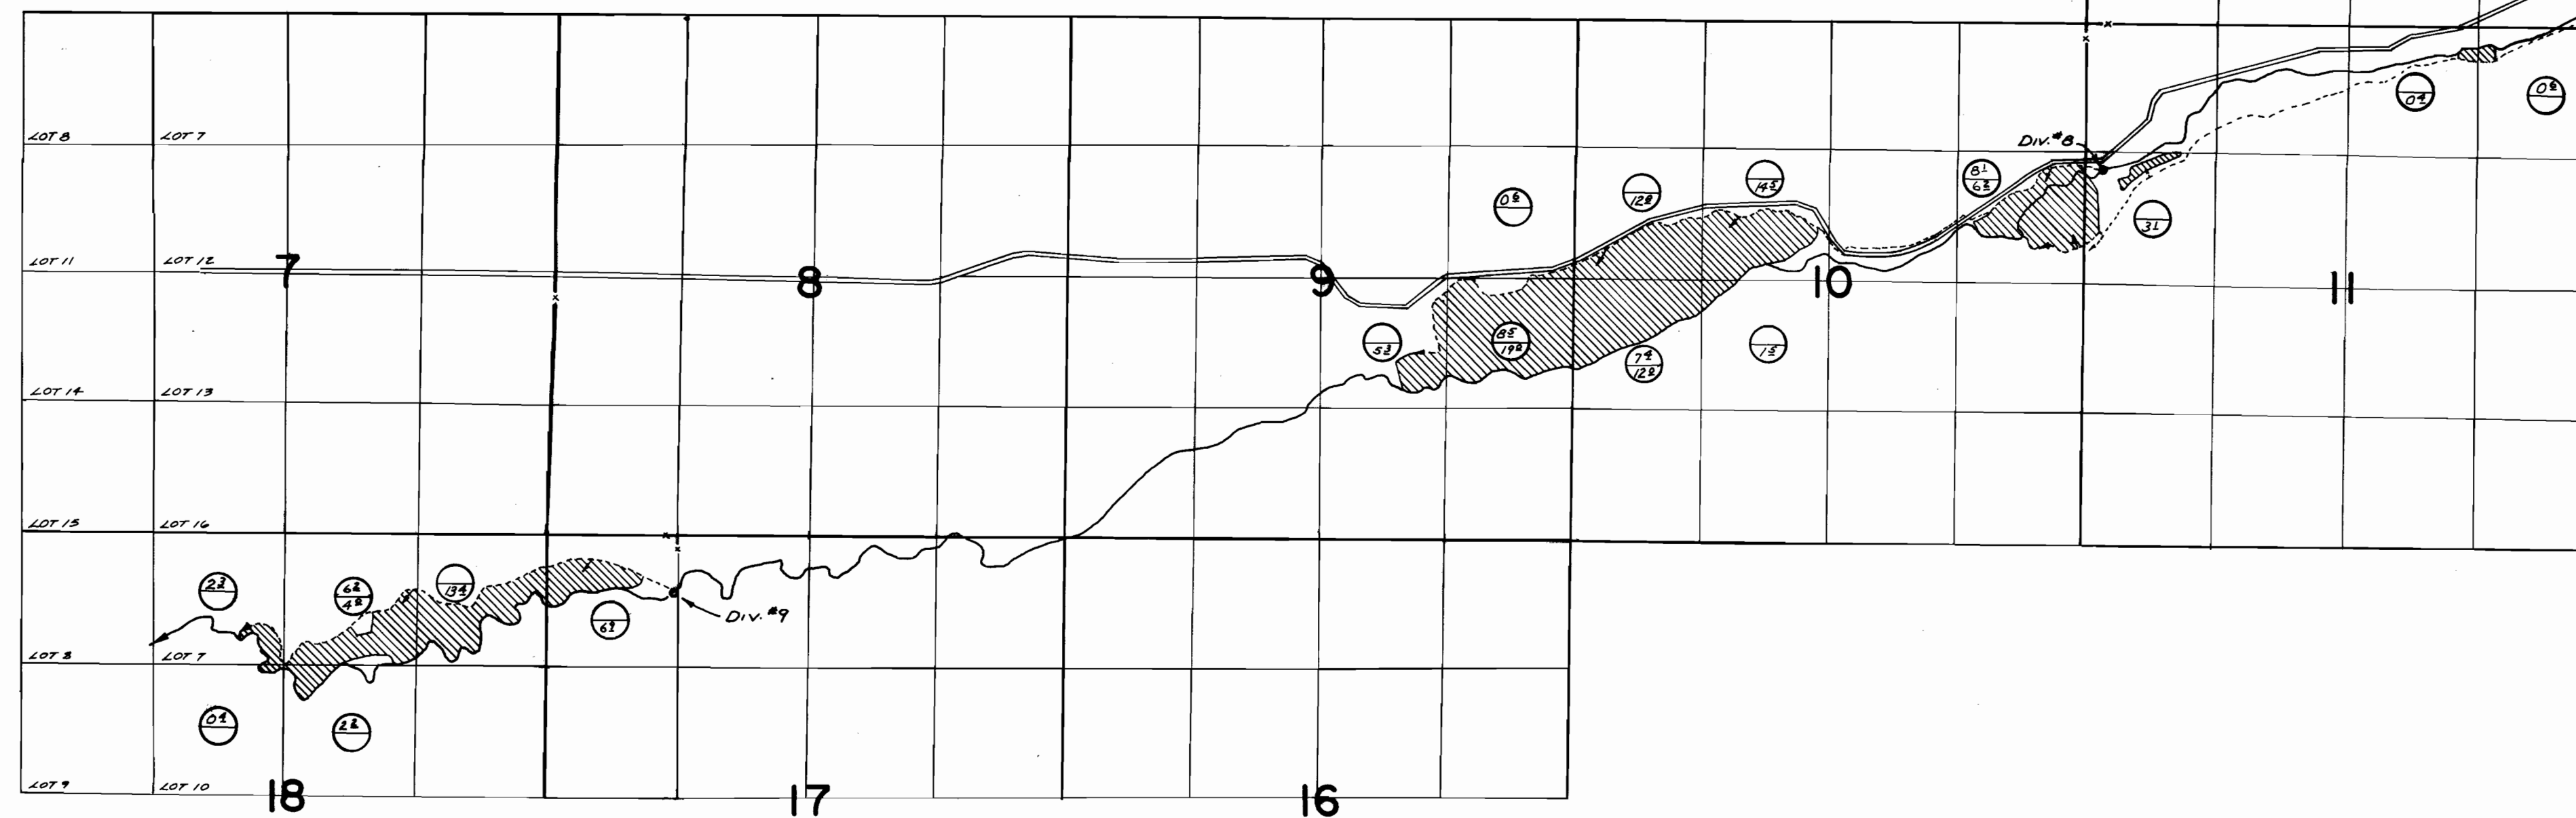

DIV. PTS. LOC: BEAR CR. *1-1000'N & 1600'E FROM S.W. COR. SEC.13, *2-3700'N & 1900'W, *3-3050'N & 3810'W, *4-1720'N & 4680'W FROM S.E. COR. SEC.29, *5-3850'N & 1850'E FROM S.W. COR. SEC.31, T.18S. R.19E. W.M., *6-750'S & 420'W FROM N.E. COR. SEC.1, *7-370'N & 50'W FROM S.E. COR. SEC.2, *8-1470'S & 180'E FROM N.W. COR. SEC.11, *9-500'S & 30'W FROM N.E. COR. N.W. & N.W. SEC.17, T.19S. R.18E. W.M.
 SOLDIER CR. - 2800'N & 3750'W FROM S.E. COR. SEC.29, T.18S. R.19E. W.M.
 FAUGHT CREEK - 2720'N & 1030'W, UNNAMED CREEK - 1880'N & 620'E, BOTH FROM S.W. COR. SEC.13, T.18S. R.19E. W.M.

FINAL PROOF SURVEY

UNDER

APPLICATION NO. R-25608	PERMIT NO. R-1805
28024	23916
R-30697	R-1915
30698	24428
R-34948	R-2657
34949	27526

IN NAME OF

WILLIAM R. MCCORMACK

SURVEYED JUNE 25-26, 1974 BY R. MUCKEN