


T.29S. R.4W. W.M.

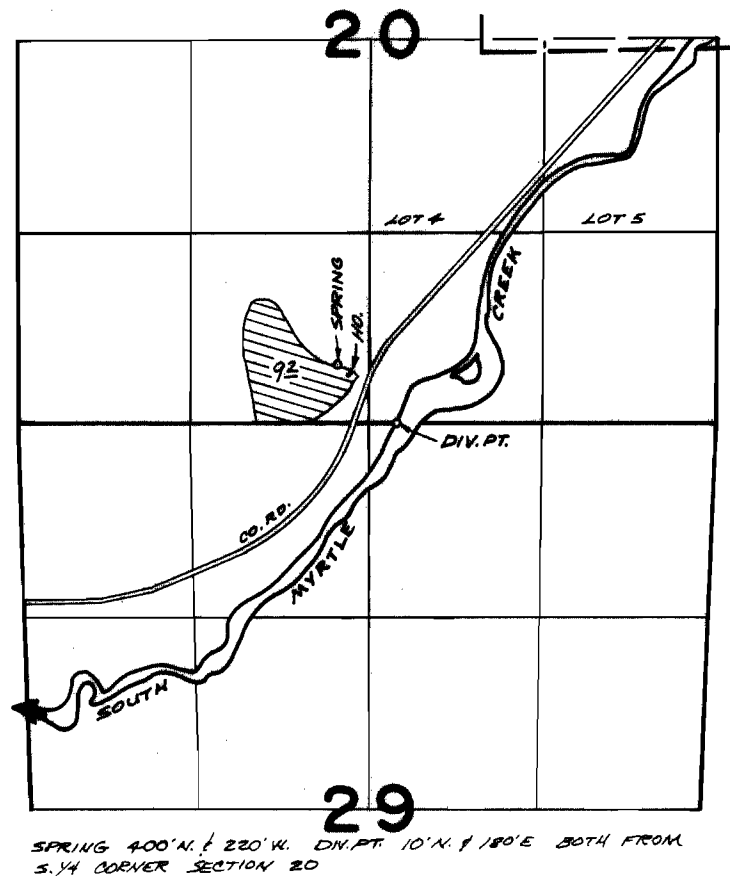

SPRING 400' N. & 220' W. DIV. PT. 10' N. & 180' E. BOTH FROM
S. 1/4 CORNER SECTION 20

FINAL PROOF SURVEY
UNDER

Application No. 44718 Permit No. 33502
IN NAME OF

WILLIE Mc CARLEY

Surveyed JUNE 18 1914, by D. NORBY