


T. 30 S. R. 5 W. W.M.

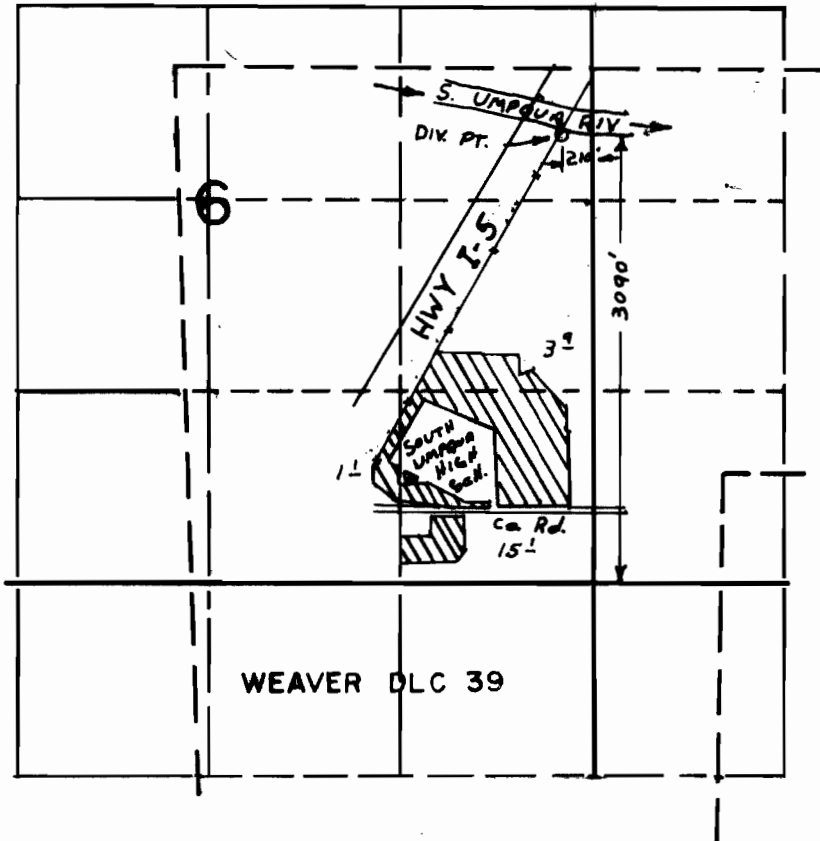

FINAL PROOF SURVEY
UNDER

Application No. 45383 Permit No. 33882...
IN NAME OF
SOUTH UMPQUA SCHOOL
DISTRICT No 19

Surveyed JULY 11 1974, by L. H. NUNN.