


T32S R5W WM

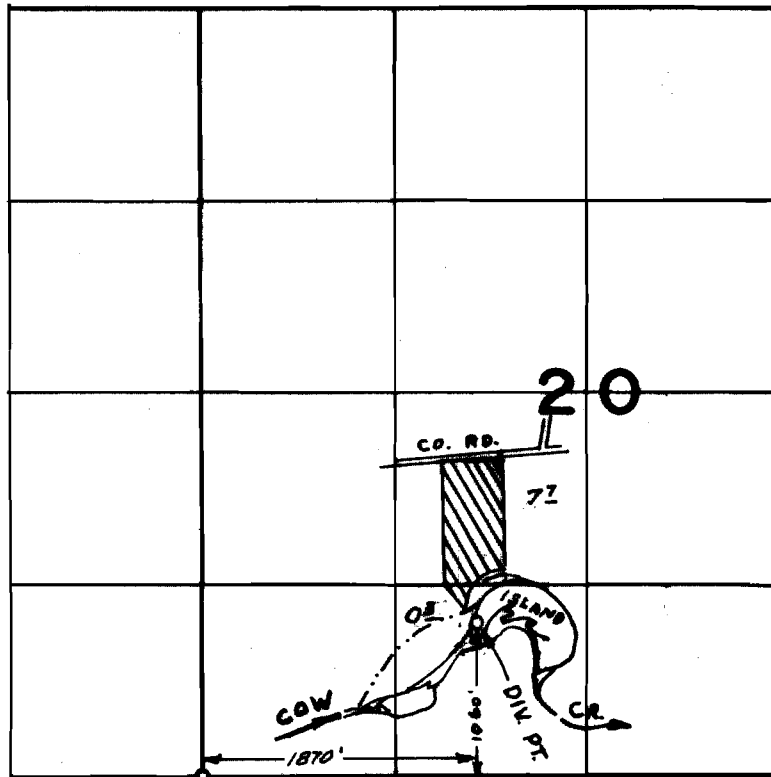

FINAL PROOF SURVEY
UNDER

Application No. 45539 Permit No. 33977
IN NAME OF

ROBERT & MARGUERITE STEVENS

Surveyed JULY 10 1974, by L.H. NUNN