


# T.22S.R.8W.W.M.

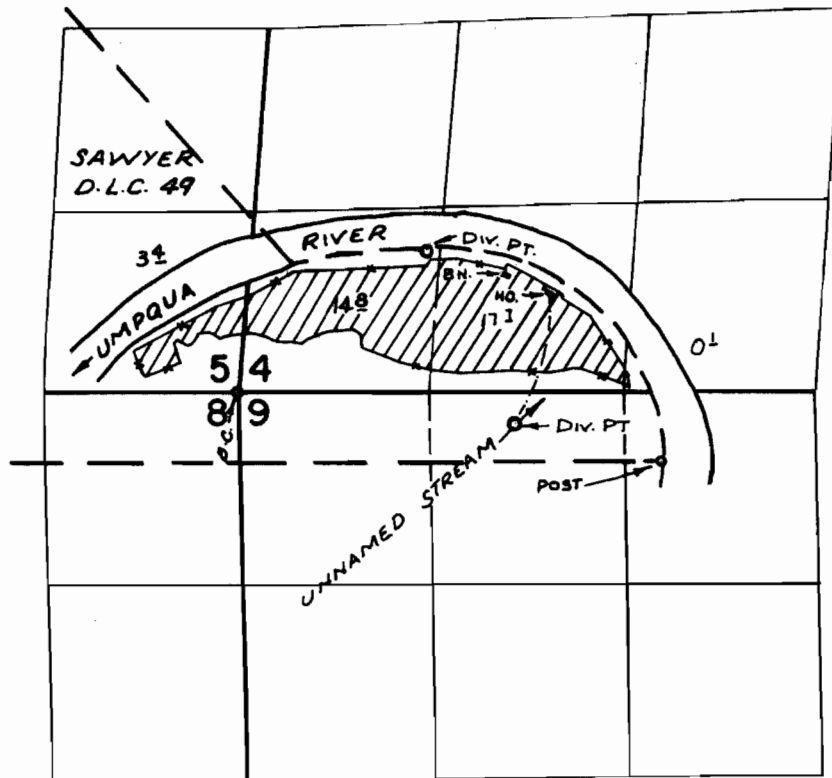

DIV. PTS. LOC: UNN. STR - 220' S. & 1900' E., RIVER - 970' N. & 1280' E., BOTH FROM S.W. COR. SEC. 4

## FINAL PROOF SURVEY UNDER

Application No. 45990 Permit No. 34320  
IN NAME OF

FORREST SOLOMON

Surveyed MAY 1, 1974, by R. MUCKEN