


T.23S.R.5W.W.M.

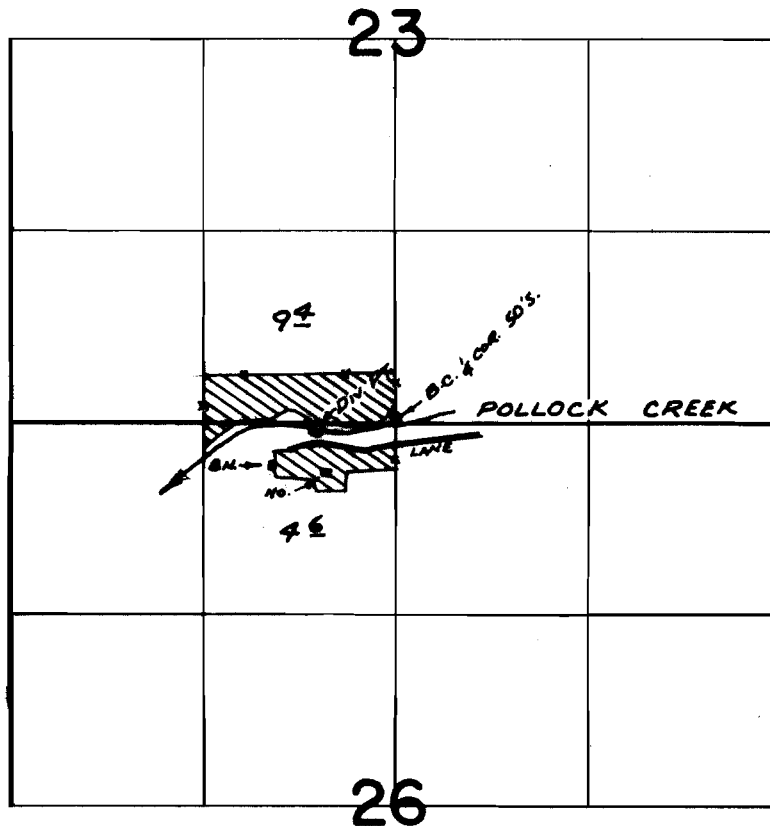

FINAL PROOF SURVEY
UNDER

Application No. 46314..... Permit No. 34605.....
IN NAME OF

.....GEORGE WHITE.....

Surveyed OCT. 16, 1974, by R. MUCKEN