


# T. 22S.R. 6W.W.M.

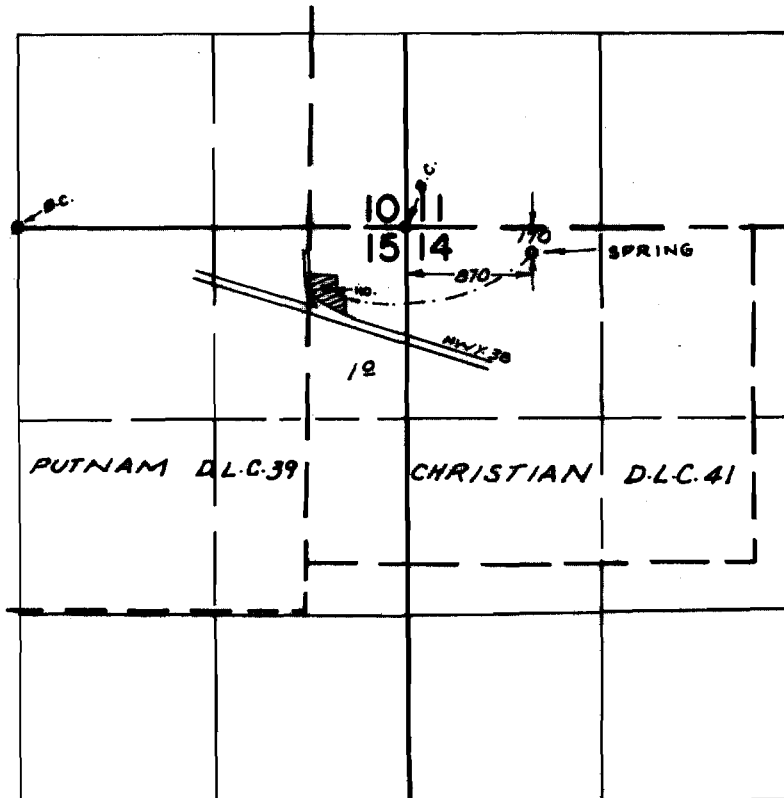

## FINAL PROOF SURVEY UNDER

Application No. 46378... Permit No. 34638..  
IN NAME OF

WARREN T. & MARGARET A. DE LA VERGNE

Surveyed APR. 30, 1974, by R. MUCKEN