


T.26S.R.4W.W.M.

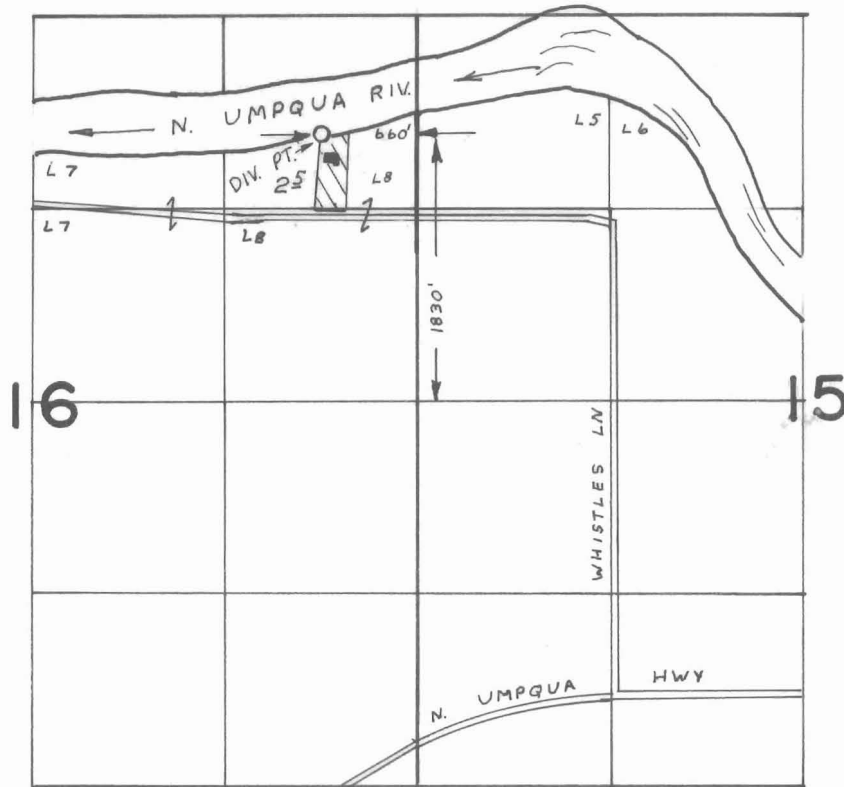

FINAL PROOF SURVEY UNDER

Application No. 46789 Permit No. 34989
IN NAME OF

M. PAUL AND LILLIAN KNIGHT

Surveyed AUG. 29. 19.74, by L. H. NUNN