


T.30S.R.5W.W.M.

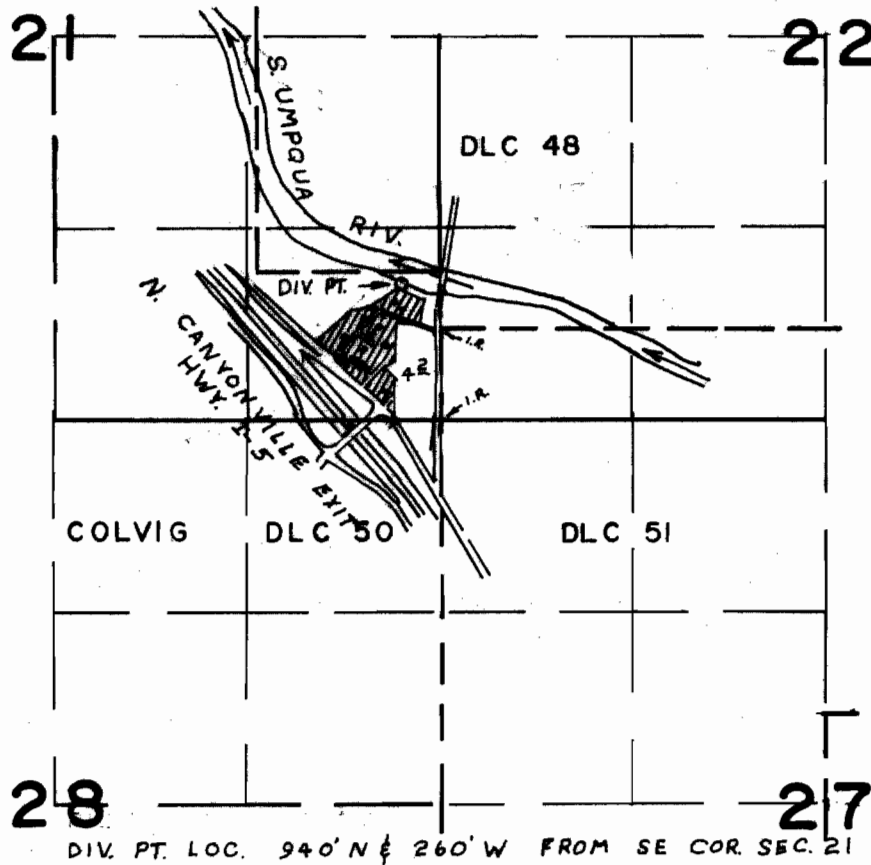

FINAL PROOF SURVEY
UNDER

Application No. 46905 Permit No. 35091
IN NAME OF

INDIAN SPRINGS WATER DISTRICT

Surveyed JULY 8, 1974, by L. H. NUNN