


T.22&23S.R.5W.W.M.

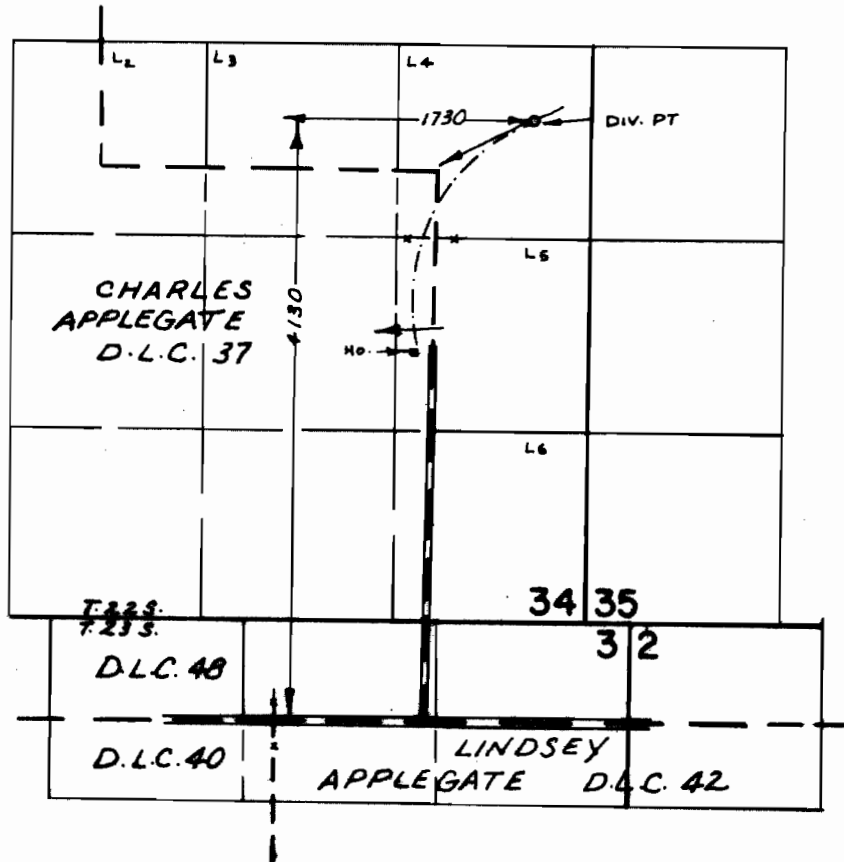

FINAL PROOF SURVEY UNDER

Application No. 47292 Permit No. 35322
IN NAME OF

REX APPELEGATE

Surveyed APR. 29, 1974, by R. MUCKEN