


T.28&29S. R.4W. W.M.

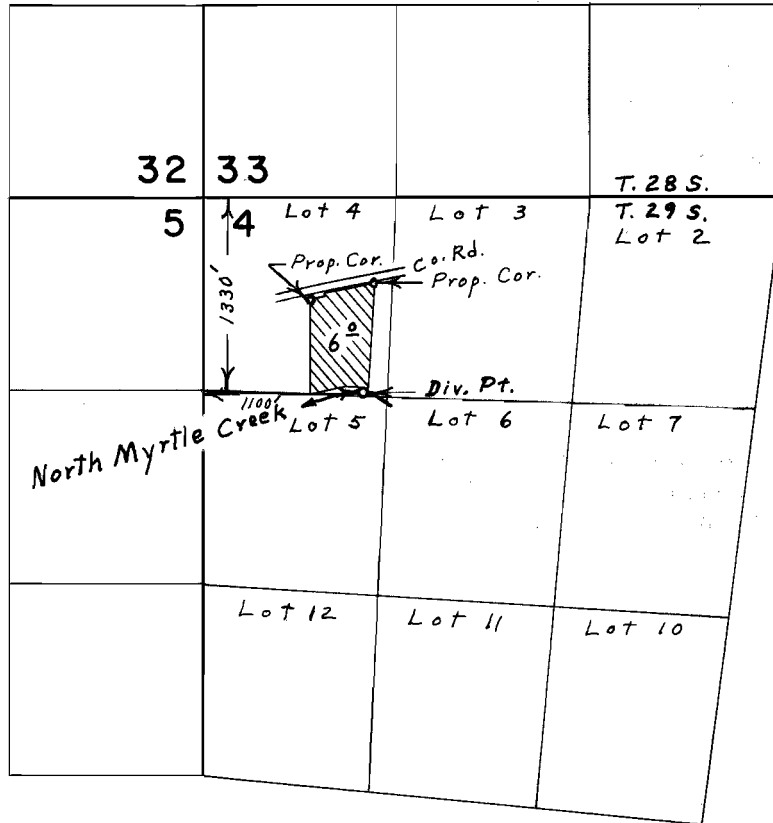

FINAL PROOF SURVEY
UNDER

Application No. 48450 Permit No. 35963
IN NAME OF

DALE L. SHIELDS

Surveyed June 19, 1974, by Dave Norby