


# T. 24 S. R. 7 W. W.M.

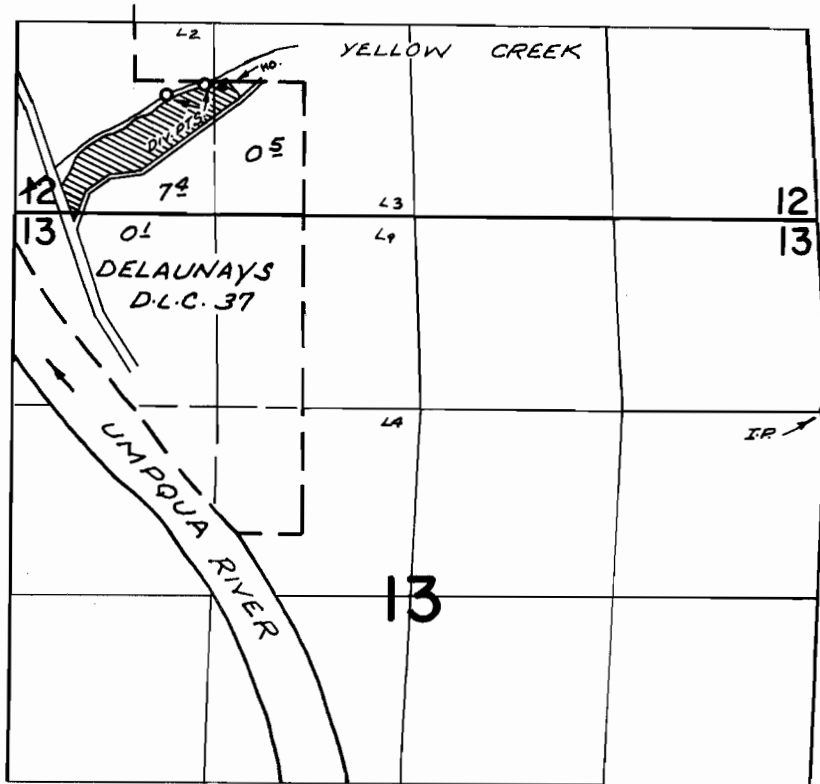

DIV. PTS. LOC: 2220'N & 4270'W; 2140'N & 4540'W, BOTH  
FROM S.E. COR. NE  $\frac{1}{4}$  NE  $\frac{1}{4}$  SEC. 13

## FINAL PROOF SURVEY UNDER

Application No. 48263 Permit No. 36237  
IN NAME OF

JAMES DANIEL NEWKIRK

Surveyed OCT. 15, 1974, by R. MUCKEN