


T. 26S. R. 4W. W.M.

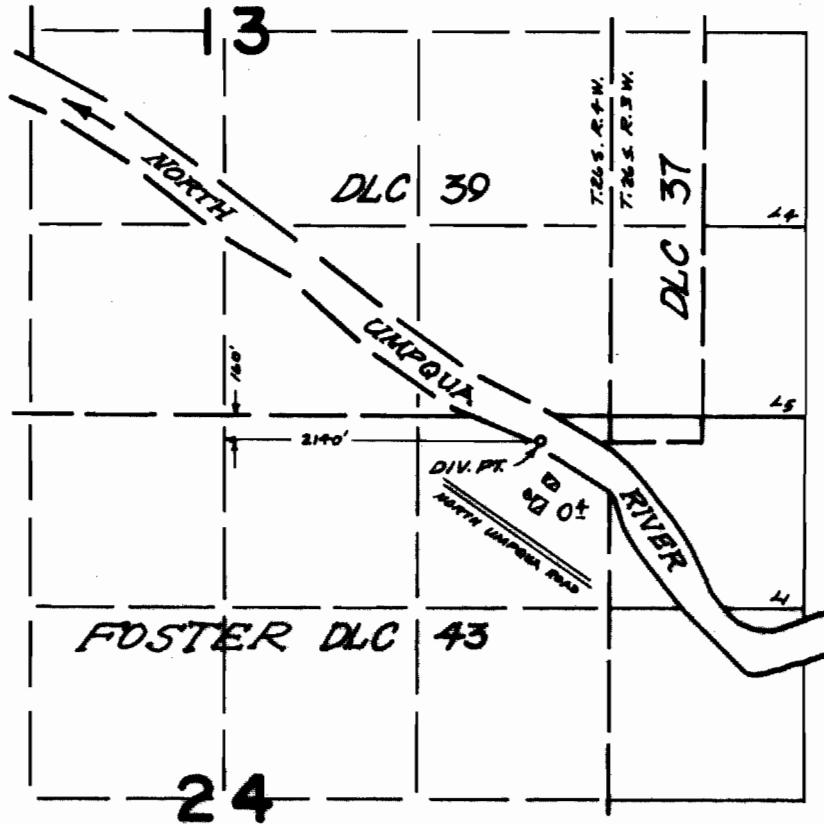

FINAL PROOF SURVEY
UNDER

Application No. 48538 Permit No. 36430
IN NAME OF

AUSTIN V. DUMONT

Surveyed AUGUST 23 1974, by L.M. TOLH