


T.23S.R.4W.W.M.

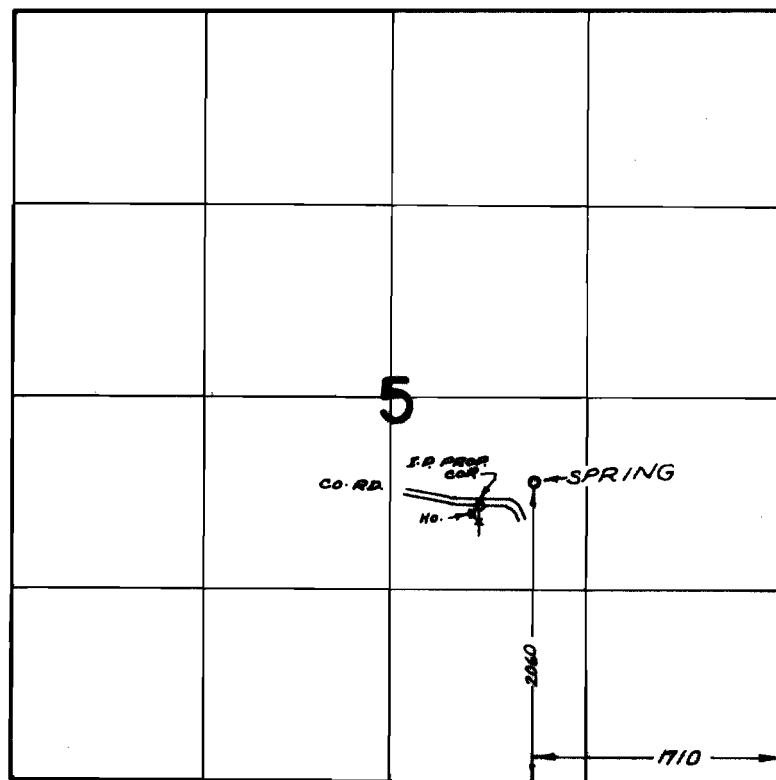

FINAL PROOF SURVEY
UNDER

Application No. 41339 Permit No. 36989
IN NAME OF

HARRY T. PASELK

Surveyed OCT. 17, 1974, by R. MUCKEN