


# T. 28 S. R. 6 W. W.M.

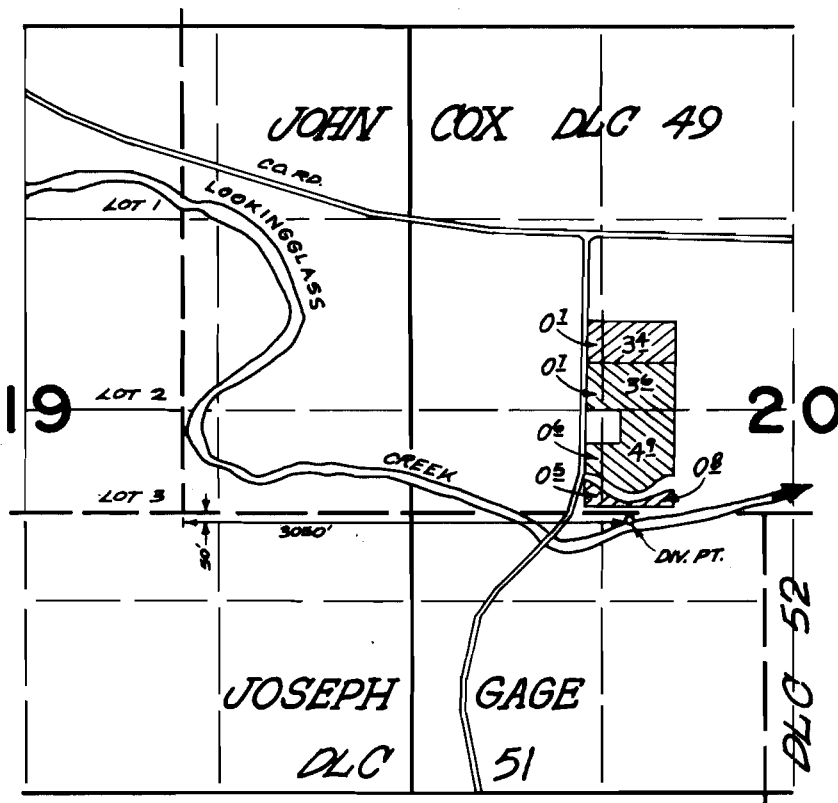

## FINAL PROOF SURVEY UNDER

TRANSFER NO. 2674

Application No. 49465 Permit No. 37053  
IN NAME OF

EDWIN D. COLLINS

Surveyed JUNE 17 1974, by P. NORBY

