


T. 26 S. R. 3 W. W.M.

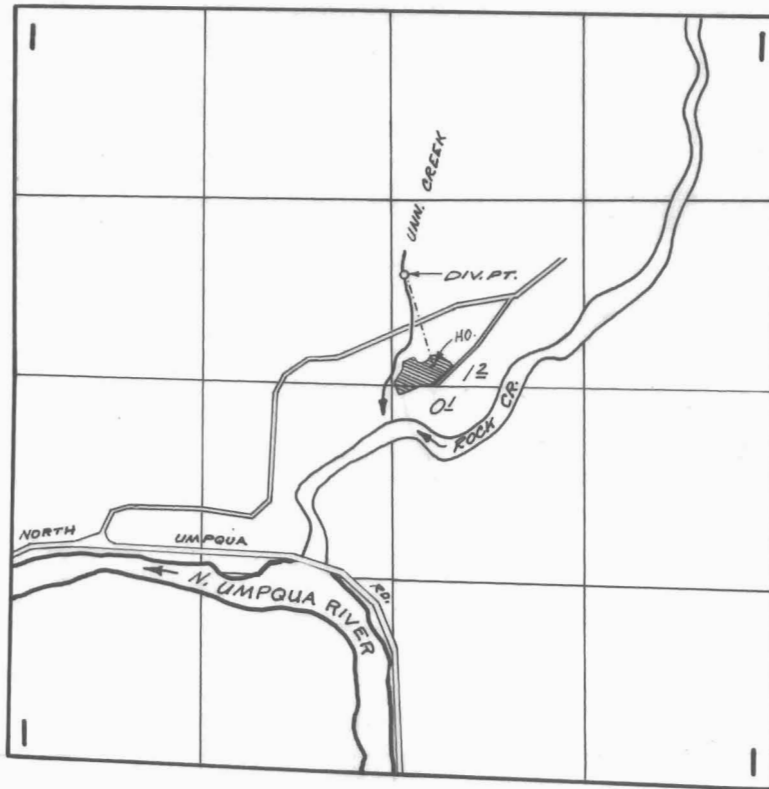

DIV. PT. ; 760' N., 90' E. FROM CENTER SECTION 1

FINAL PROOF SURVEY
UNDER

Application No. 49530... Permit No. 37073...
IN NAME OF

EUGENE R. & JOYCE V. CERMAK

Surveyed JUNE 19, 1974, by L.M. TOLL.....