


T30S R5W WM

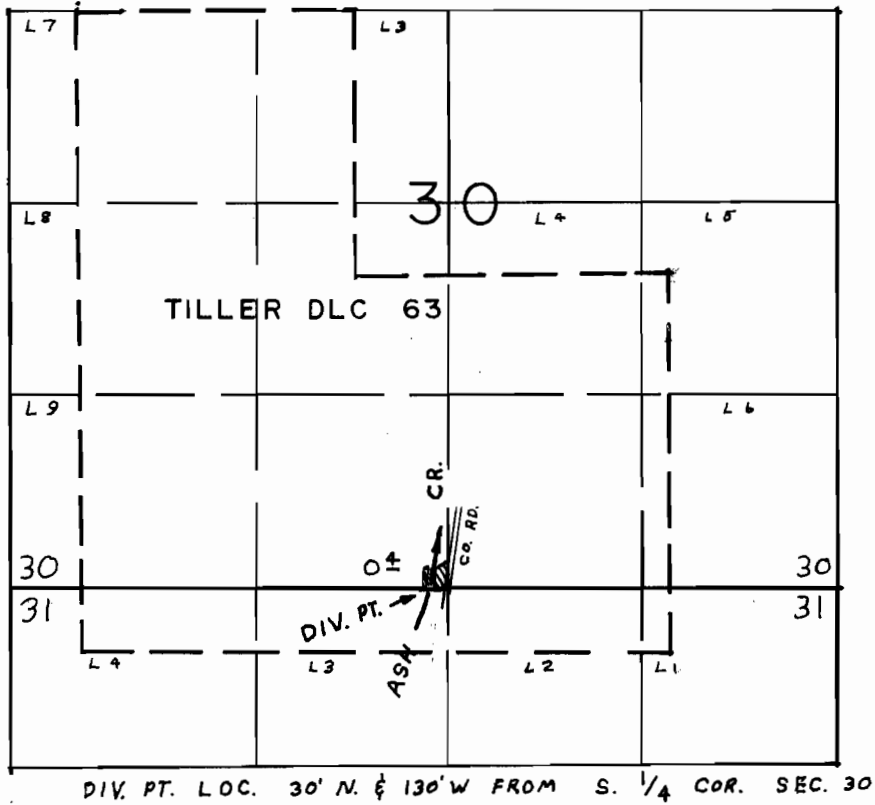

FINAL PROOF SURVEY UNDER

Application No. 49748 Permit No. 37252
IN NAME OF

MEADE CARDINAL

Surveyed JULY 9 1974 by L H NUNN