


T.23S.R.5W.W.M.

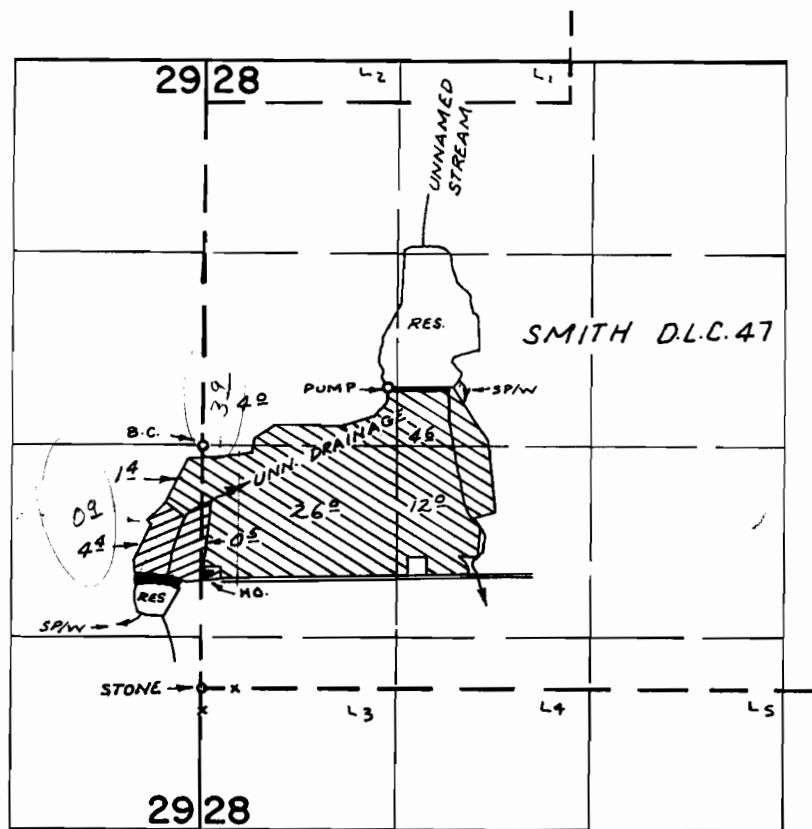

PERMIT 32192  PERMIT 31727 
 DIV. PTS. LOC: 400' N. & 1670' E; 950' S. & 220' W, BOTH
 FROM W 1/4 COR. SEC. 28

FINAL PROOF SURVEY UNDER

R-43052 R-4818
 43053 31727
 R-43166 R-4909

Application No. 43191 Permit No. 32192
 IN NAME OF

THURMAN WEAVER

Surveyed MAY 3, 1974, by R. MUCKEN