


T.23S.R.5W.W.M.

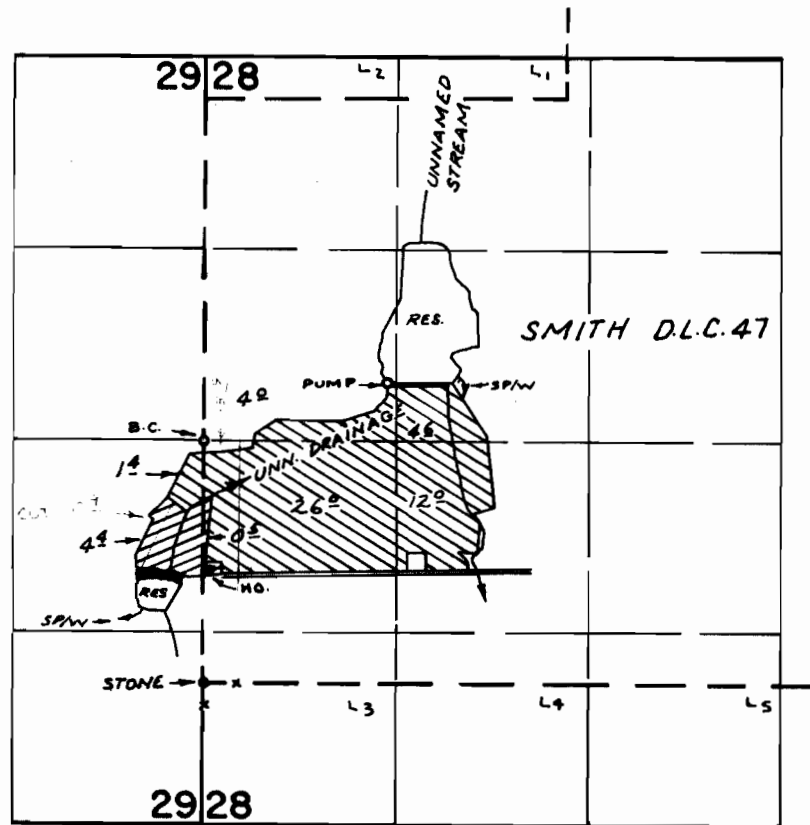

PERMIT 32192  PERMIT 31727 
 DIV. PTS. LOC: 400' N. & 1670' E ; 950' S. & 220' W, BOTH
 FROM W 1/4 COR. SEC. 28

FINAL PROOF SURVEY

UNDER

R-43052

R-4818

43053

31727

R-43166

R-4909

Application No. 43141 Permit No. 32192
 IN NAME OF

THURMAN WEAVER

Surveyed MAY 3, 1974, by R. MUCKEN