


T. 27 S. R. 6 W. W.M.

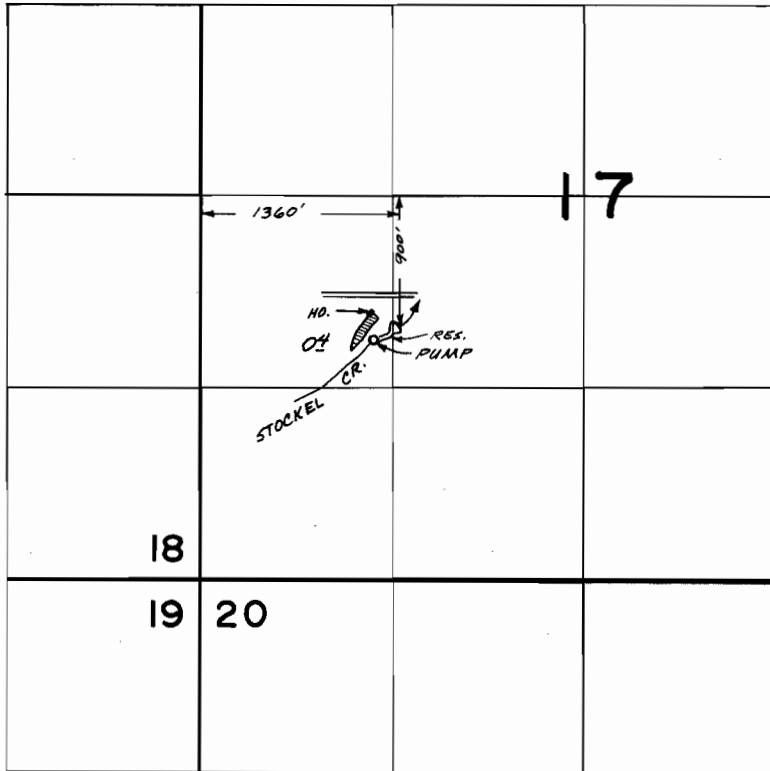

FINAL PROOF SURVEY
UNDER

R 44481 *R 5259*
Application No. 44597 Permit No. 33276
IN NAME OF

BILL LEE LAMMEY

Surveyed AUGUST 22 1974, by L.M. TOLL