


# T. 27 S. R. 6 W. W.M.

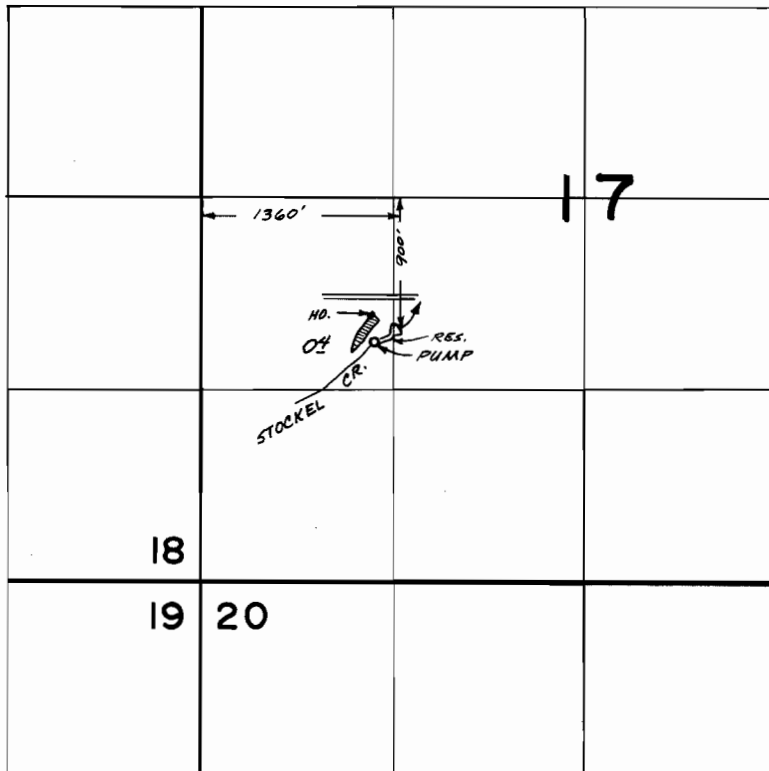

## FINAL PROOF SURVEY UNDER

*R 44481*                      *R 5259*  
Application No. 44597 Permit No. 33276  
IN NAME OF

BILL LEE LAMMEY

Surveyed AUGUST 22 1974, by L.M. TOLL