


P. 345+2
42653

T.9S. R.31E. W.M.

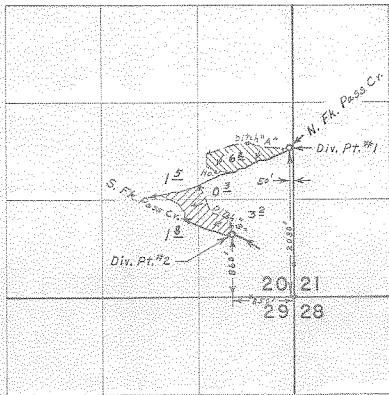

FINAL PROOF SURVEY
UNDER

Application No. 46232. Permit No. 34542.
IN NAME OF

CLAYTON E. CARR

Surveyed June 7, 1974, by L. E. Gould