


P 35892
C-42654

T.14 S. R.34 E. W.M.

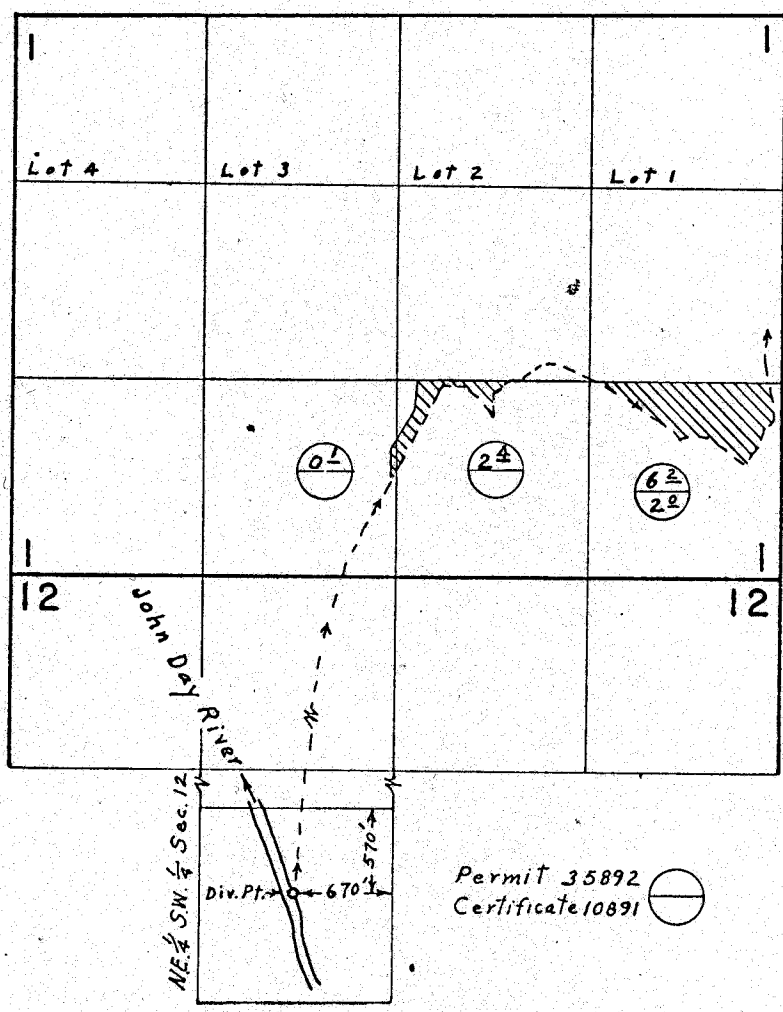

FINAL PROOF SURVEY UNDER

Application No. 47892 Permit No. 35892
IN NAME OF Certificate 42654
WAYNE E. & KATHERINE M. DEXTER

Surveyed June 13, 1974 by L. E. Gould
July 18, 1968, by W. J. Ruppert.