G-3796

42454

T.34S. R.8E. W.M.

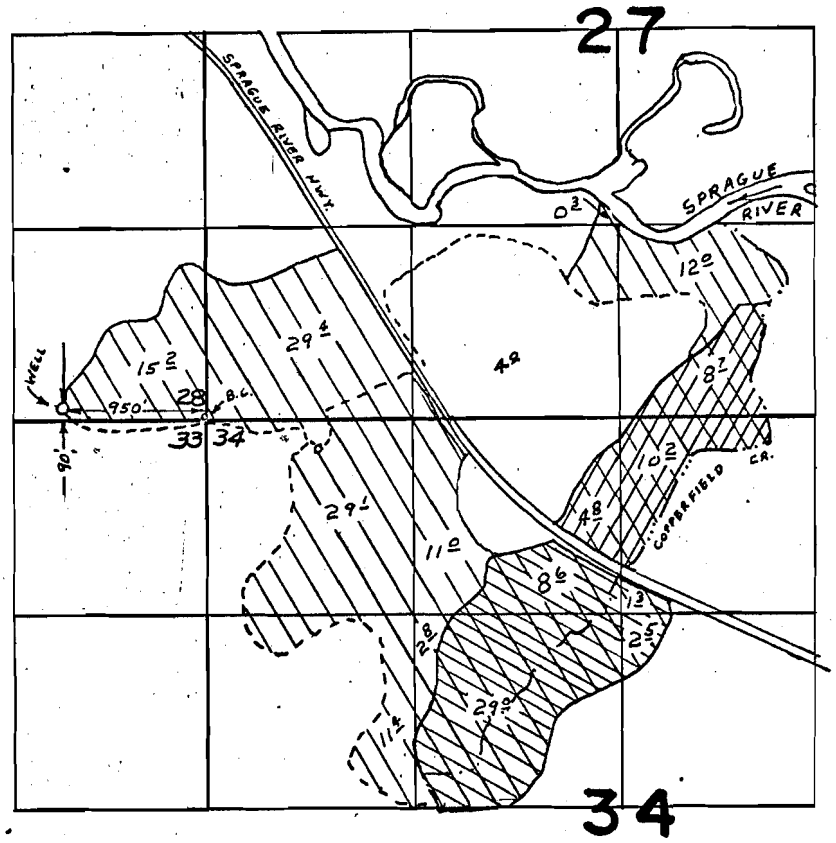

PRIMARY

SUPPLEMENTAL

Sprague River wells

FINAL PROOF SURVEY
UNDER

Application No. G-4046 Permit No. G-3796
IN NAME OF

DOROTHEA M. POOLE & ROBERT MOISIO

Surveyed OCT 21 1974, by LH NUNN

CNO-2JJ-233 LHN