


# T.39S. R.11E. W.M.

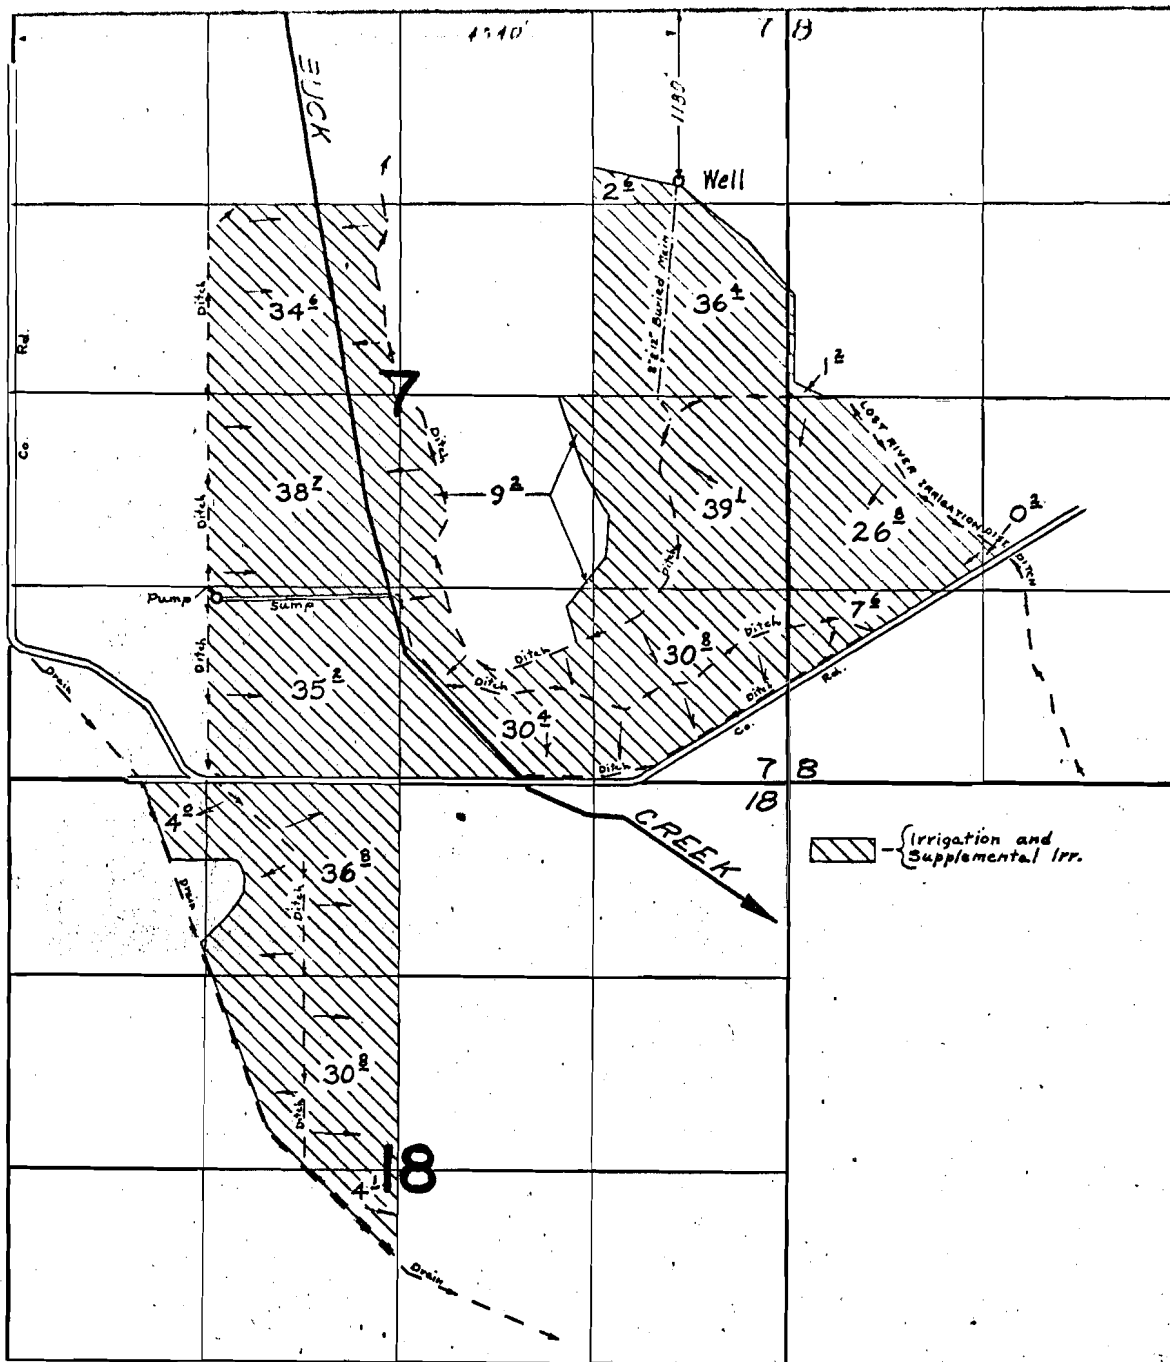

Buck Cr. & Grana Valley wells

## FINAL PROOF SURVEY UNDER

Application No. G-4252 Permit No. G-4054  
IN NAME OF

HANKINS FARMS, INC.

Surveyed OCT. 24, 1974, by L. E. GOULD