

FINAL PROOF SURVEY

UNDER

Application No. G- 5/40 Permit No. G-4873


IN NAME OF

FLYING DUTCHMEN LAND & CATTLE CO.

Surveyed Oct. 25, 1974, by L. E. Gould

G-4873

T.39S. R.11E. W.M.

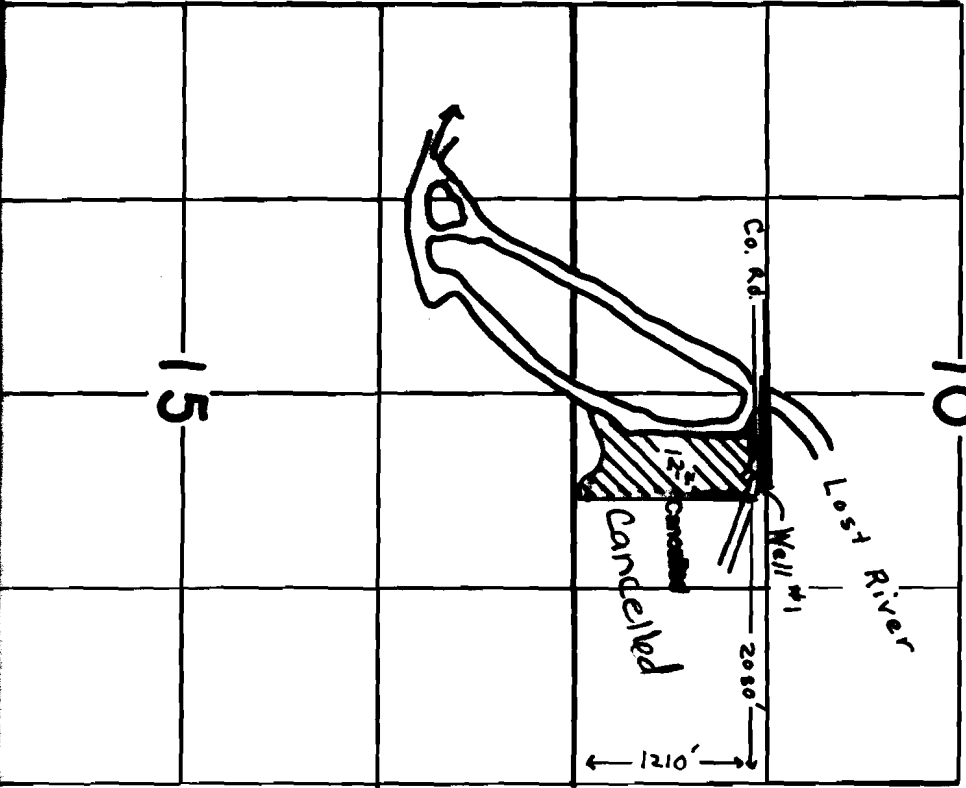

G-4873



84.0