


T.38&39S. R.1W. W.M

East River wells

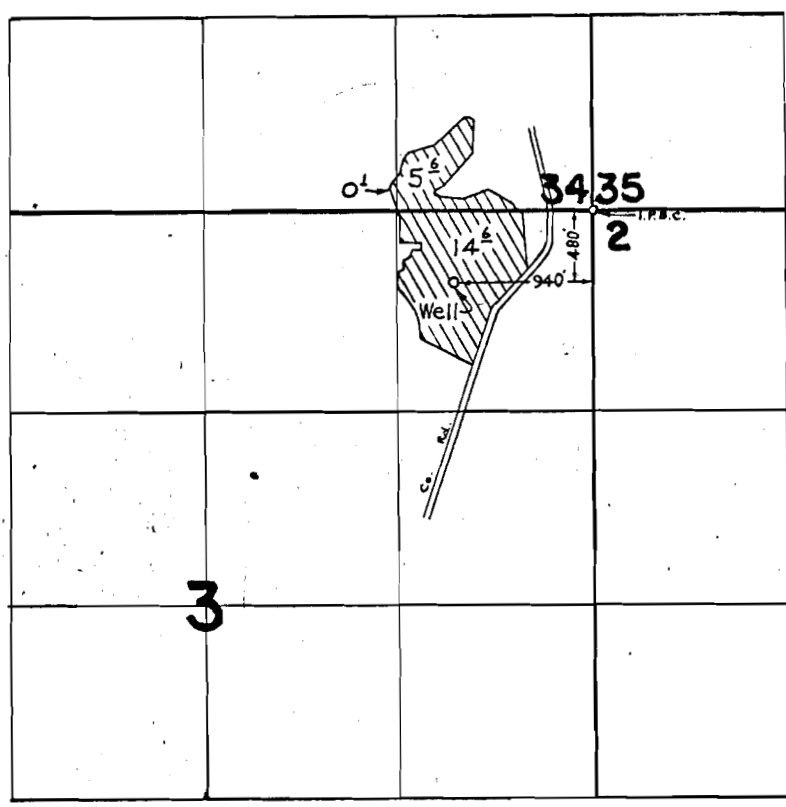

FINAL PROOF SURVEY UNDER

Application No. G-5276 Permit No. G-5119
IN NAME OF

HOWARD T. KELLISON

Surveyed OCT. 24, 1974, by L.E. GOULD