


T.35S. R.7E. W.M.

Williamson Riv. below Klamath main

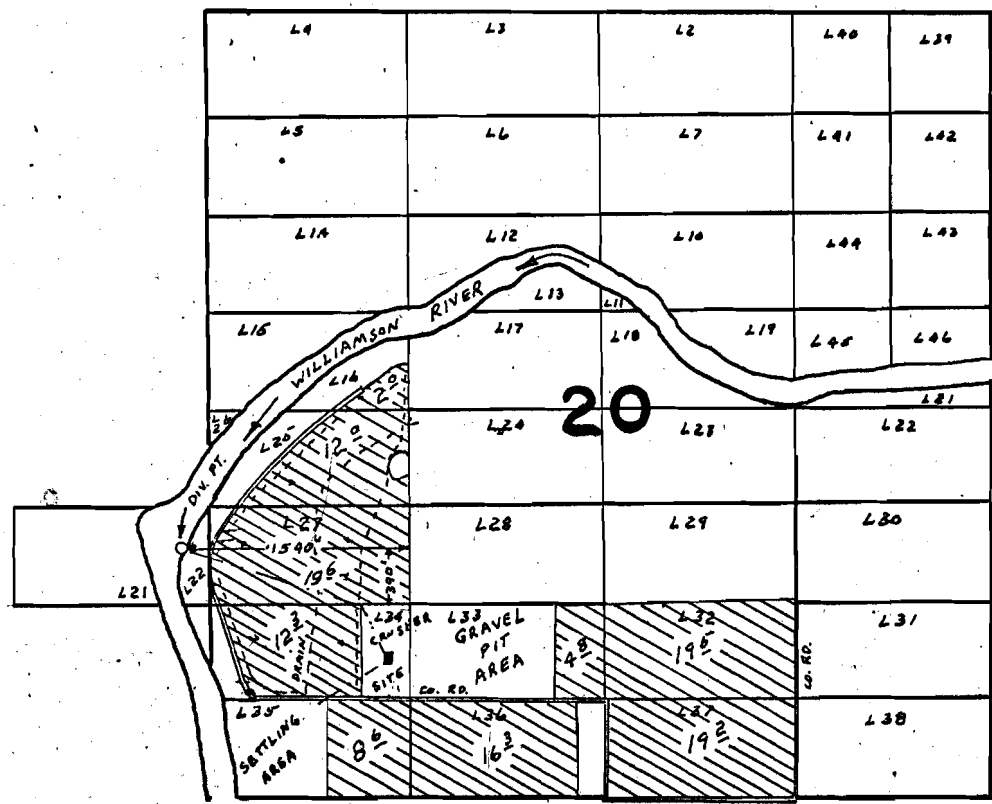

FINAL PROOF SURVEY UNDER

Application No. 45338 Permit No. 33333
IN NAME OF

STILES ENTERPRISES, INC.

Surveyed O.C.T. 18, 1974, by L.H. NUNN