


T.39S.R.13E.W.M.

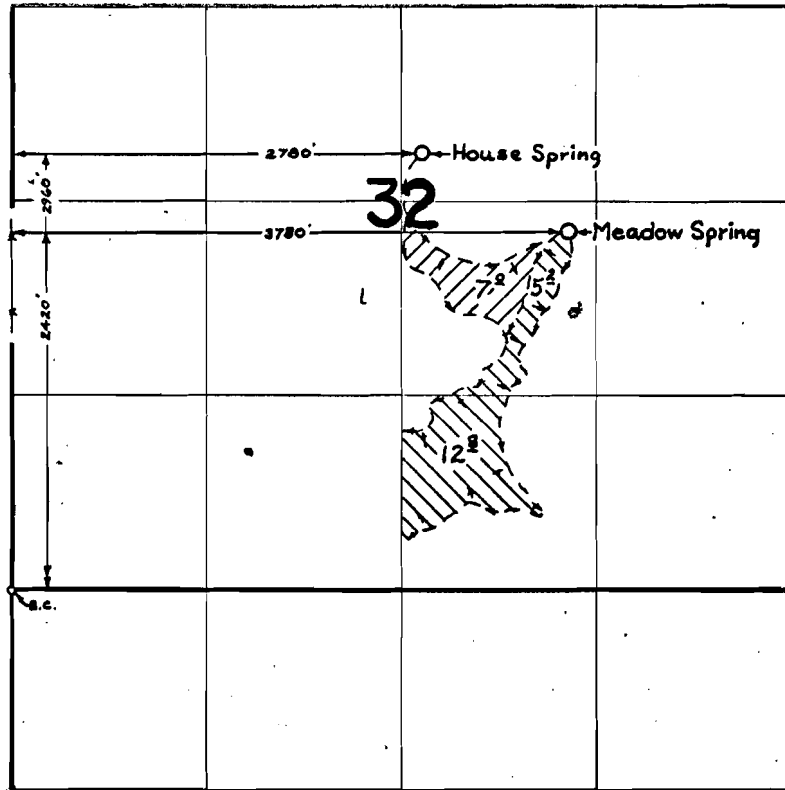

- Irr. from House Spring
- Irr. from Meadow Spring

FINAL PROOF SURVEY UNDER

Application No. 46143 Permit No. 34474
IN NAME OF

RICHARD A. SMITH

Surveyed OCT. 24, 1974, by L. E. GOULD.

Müller Ch: Misc.