


# T.40S.R.1E.W.M.

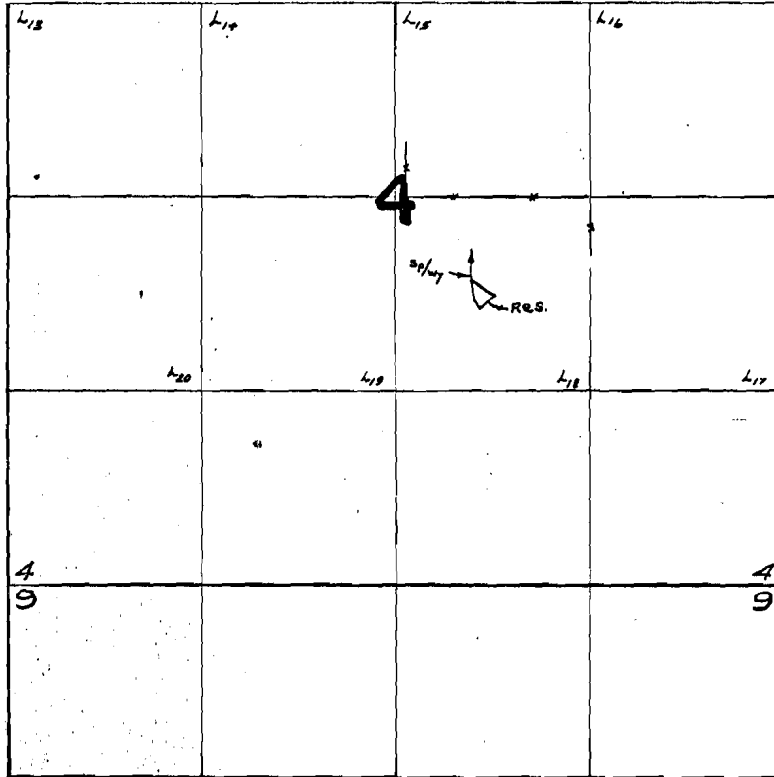

East River Misc.

## FINAL PROOF SURVEY UNDER

Application No. R-48897 Permit No. R-5960  
IN NAME OF

I. F. RODGERS.

Surveyed OCT. 25. 1974. by L. E. GOULD