


T.9S., R.1W., W.M.

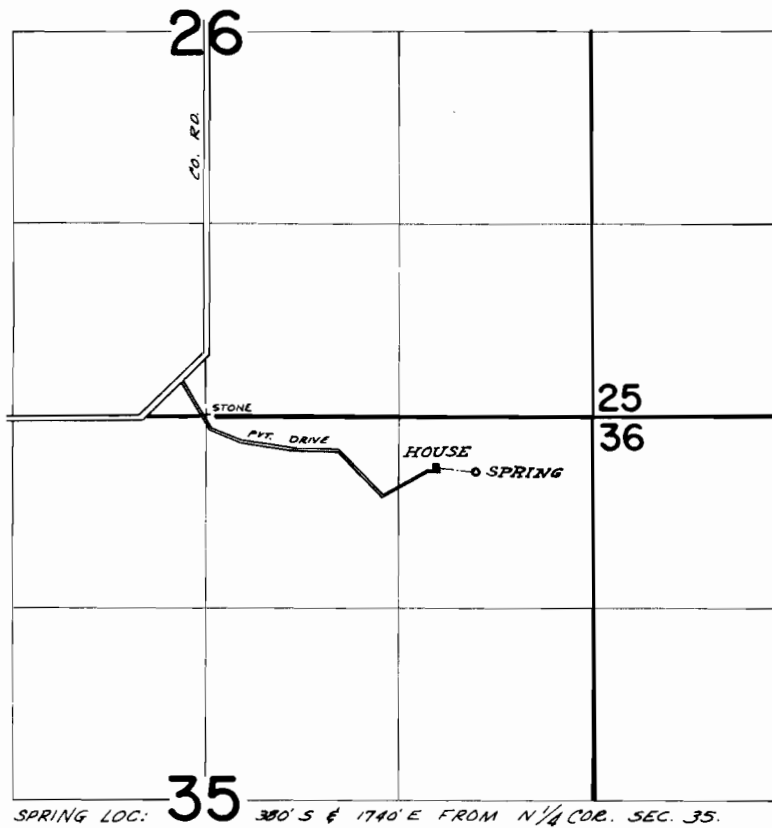

FINAL PROOF SURVEY
UNDER

Application No. **49696** Permit No. **37230**
IN NAME OF

IDA M. SANDNER

Surveyed **May 23** 1974, by **D. Norby**