


# T.19S. R.44E. W.M.

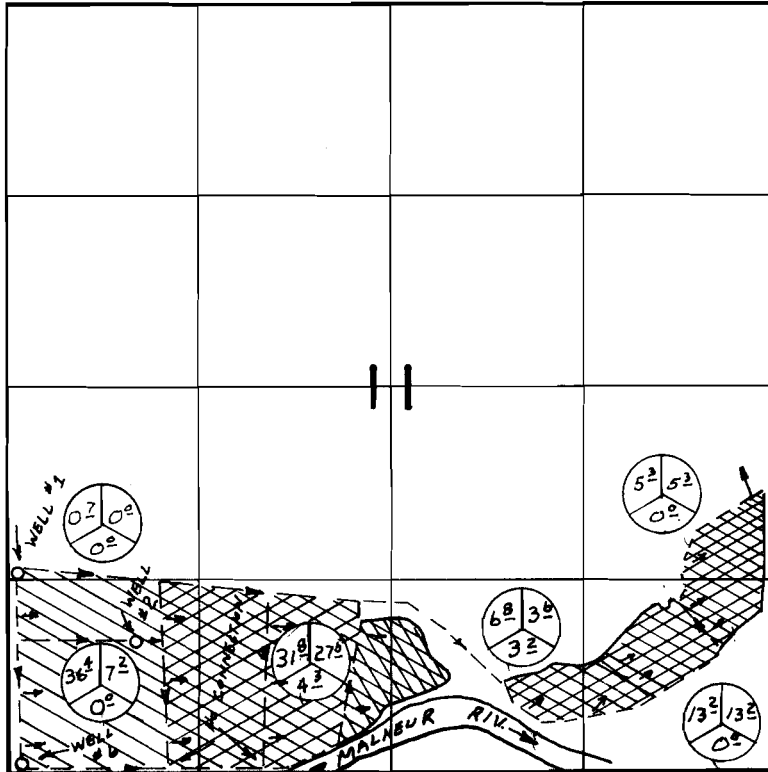

WELL 1 LOC. 1380' N & 60' E. FROM SW COR. SEC. 11  
 WELL 2 LOC. 900' N & 870' E. FROM SW COR. SEC. 11  
 WELL 6 LOC. 60' N & 90' E. FROM SW COR. SEC. 11



## FINAL PROOF SURVEY UNDER

G-4156                      G-3908  
 Application No. G-5183    Permit No. G-5055  
 IN NAME OF

RONALD FLOYD & DIANNE HAWKINS

Surveyed JUN 26 1974, by LH NUNN