


T.20S. R.46E. W.M.

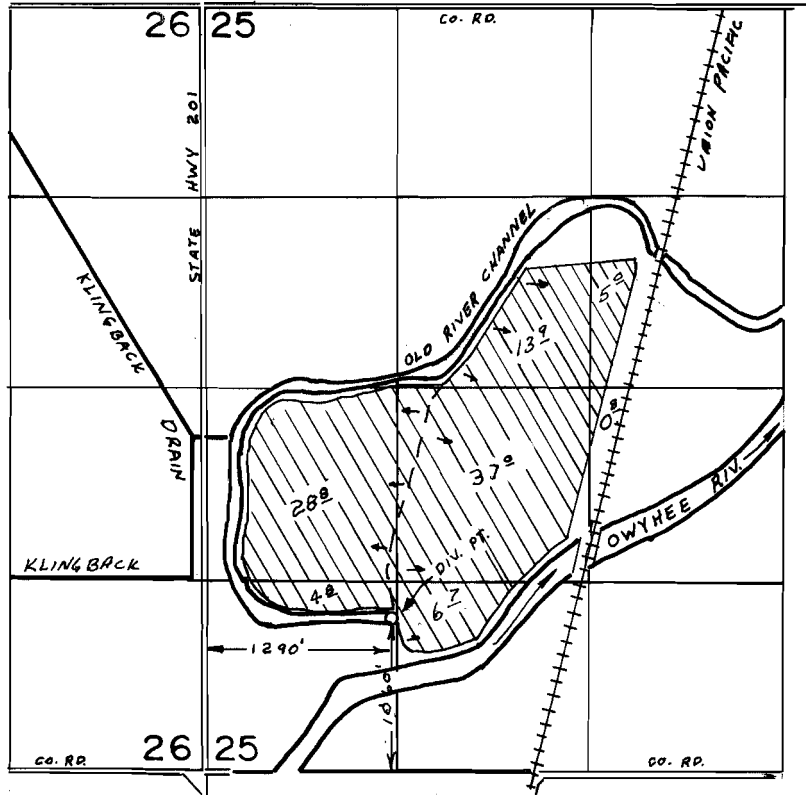

FINAL PROOF SURVEY UNDER

Application No. 39966. Permit No. 31052...
IN NAME OF

FARRELL PETERSON

Surveyed JUN 21 1974, by L H NUNN