


T.18S. R.46E. W.M.

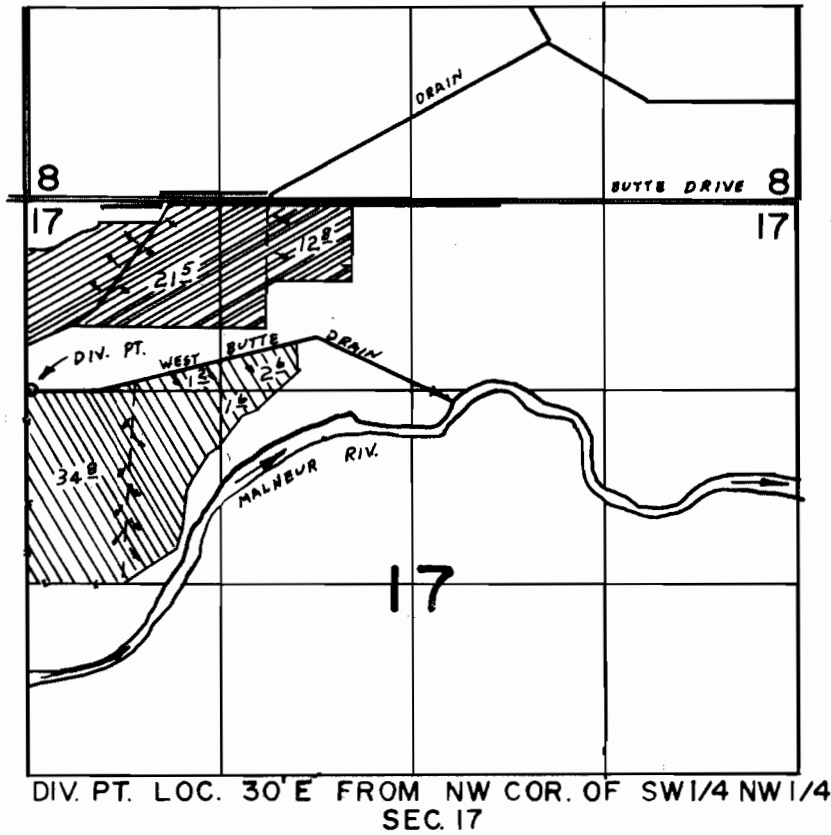

FINAL PROOF SURVEY
UNDER

Application No. 45250 Permit No. 34018
IN NAME OF

HILTON M. CLARK

Surveyed JUN 19 1974, by L.H. NUNN