
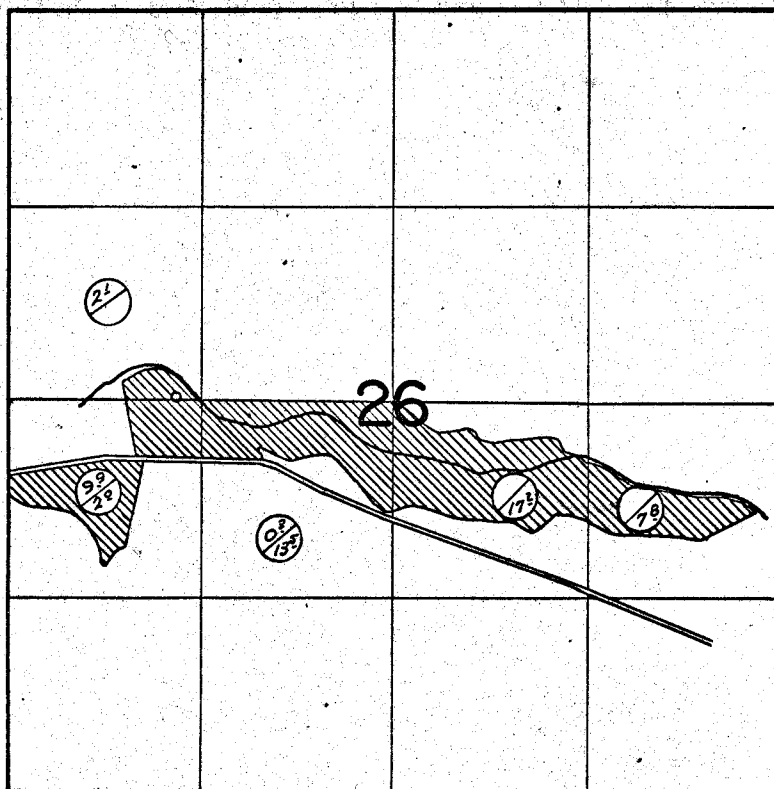


G-4712  
42672

# T.1N. R.27E. W.M.

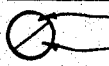

 PRIMARY  
SUPPLEMENTAL  
WELL LOC 3 20°N 1490'W FROM CENTER SEC. 26

## FINAL PROOF SURVEY UNDER

Application No. G-4994 Permit No. G-4712  
IN NAME OF

CURRIN BROTHERS

Surveyed APRIL 18, 1974, by T. J. PAUL