


T.7S.,R.6W.,W.M.

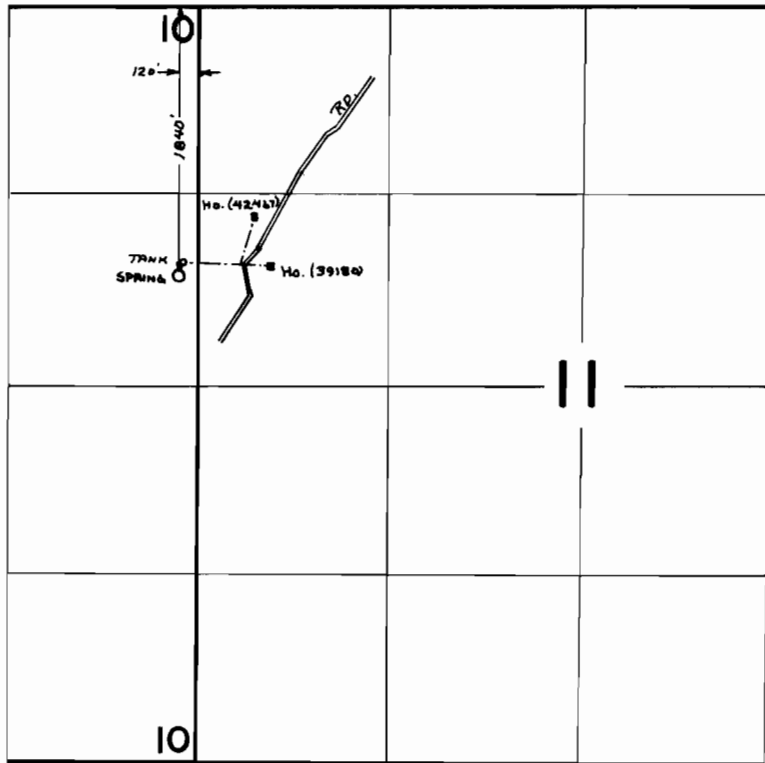

FINAL PROOF SURVEY UNDER

Application No. **42467** **39180** Permit No. **31763** **29221**
IN NAME OF

..... **HUGH E. ADAMS**

Surveyed **JUNE 13 1974**, by **L. H. NUNN**.....