


T.7S.,R.6W.,W.M.

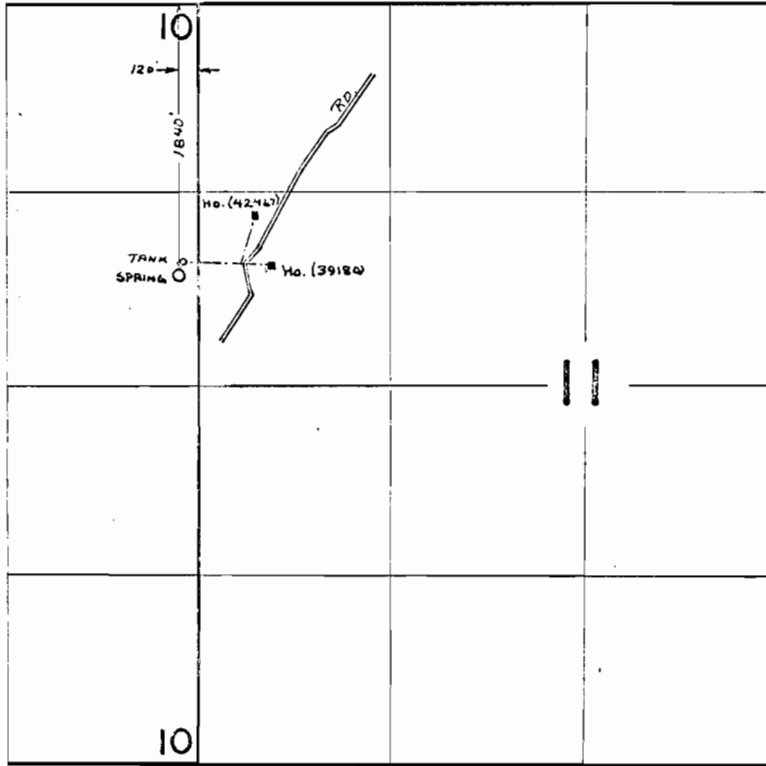

FINAL PROOF SURVEY
UNDER

Application No. 42467 Permit No. 31763
 39180 29221
IN NAME OF

HUGH E. ADAMS

Surveyed JUNE 13 1974, by L.H. NUNN