


T.8S. R.5W. W.M.

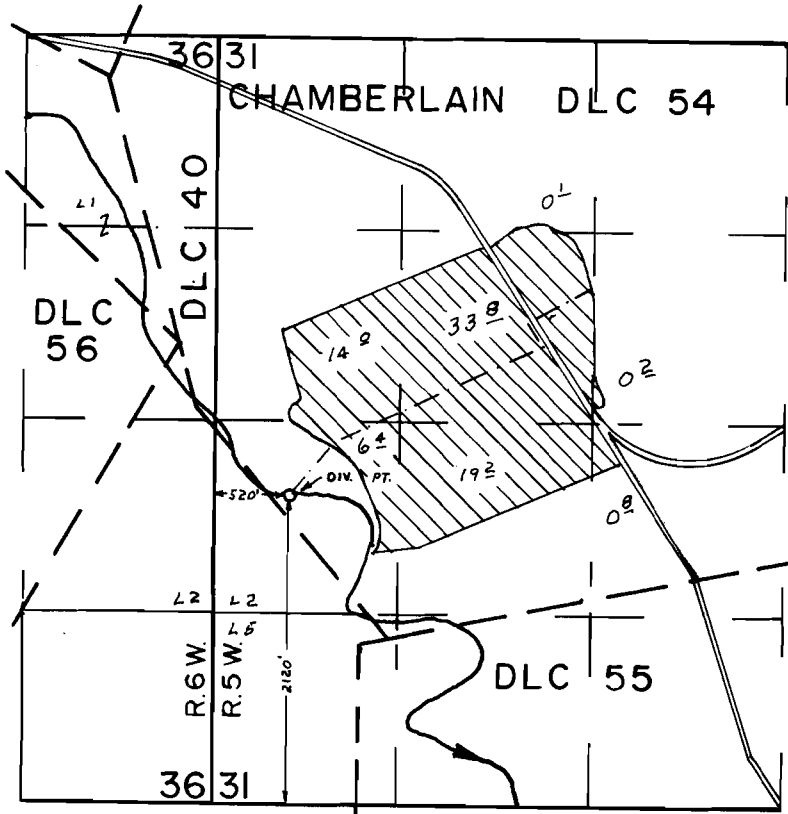

FINAL PROOF SURVEY UNDER

Application No. 46456 Permit No. 34707
IN NAME OF

NINA BRESSLER

Surveyed JUL 19 1974, by LH NUNN