


T. 4 S. R. 16 E. W. M.

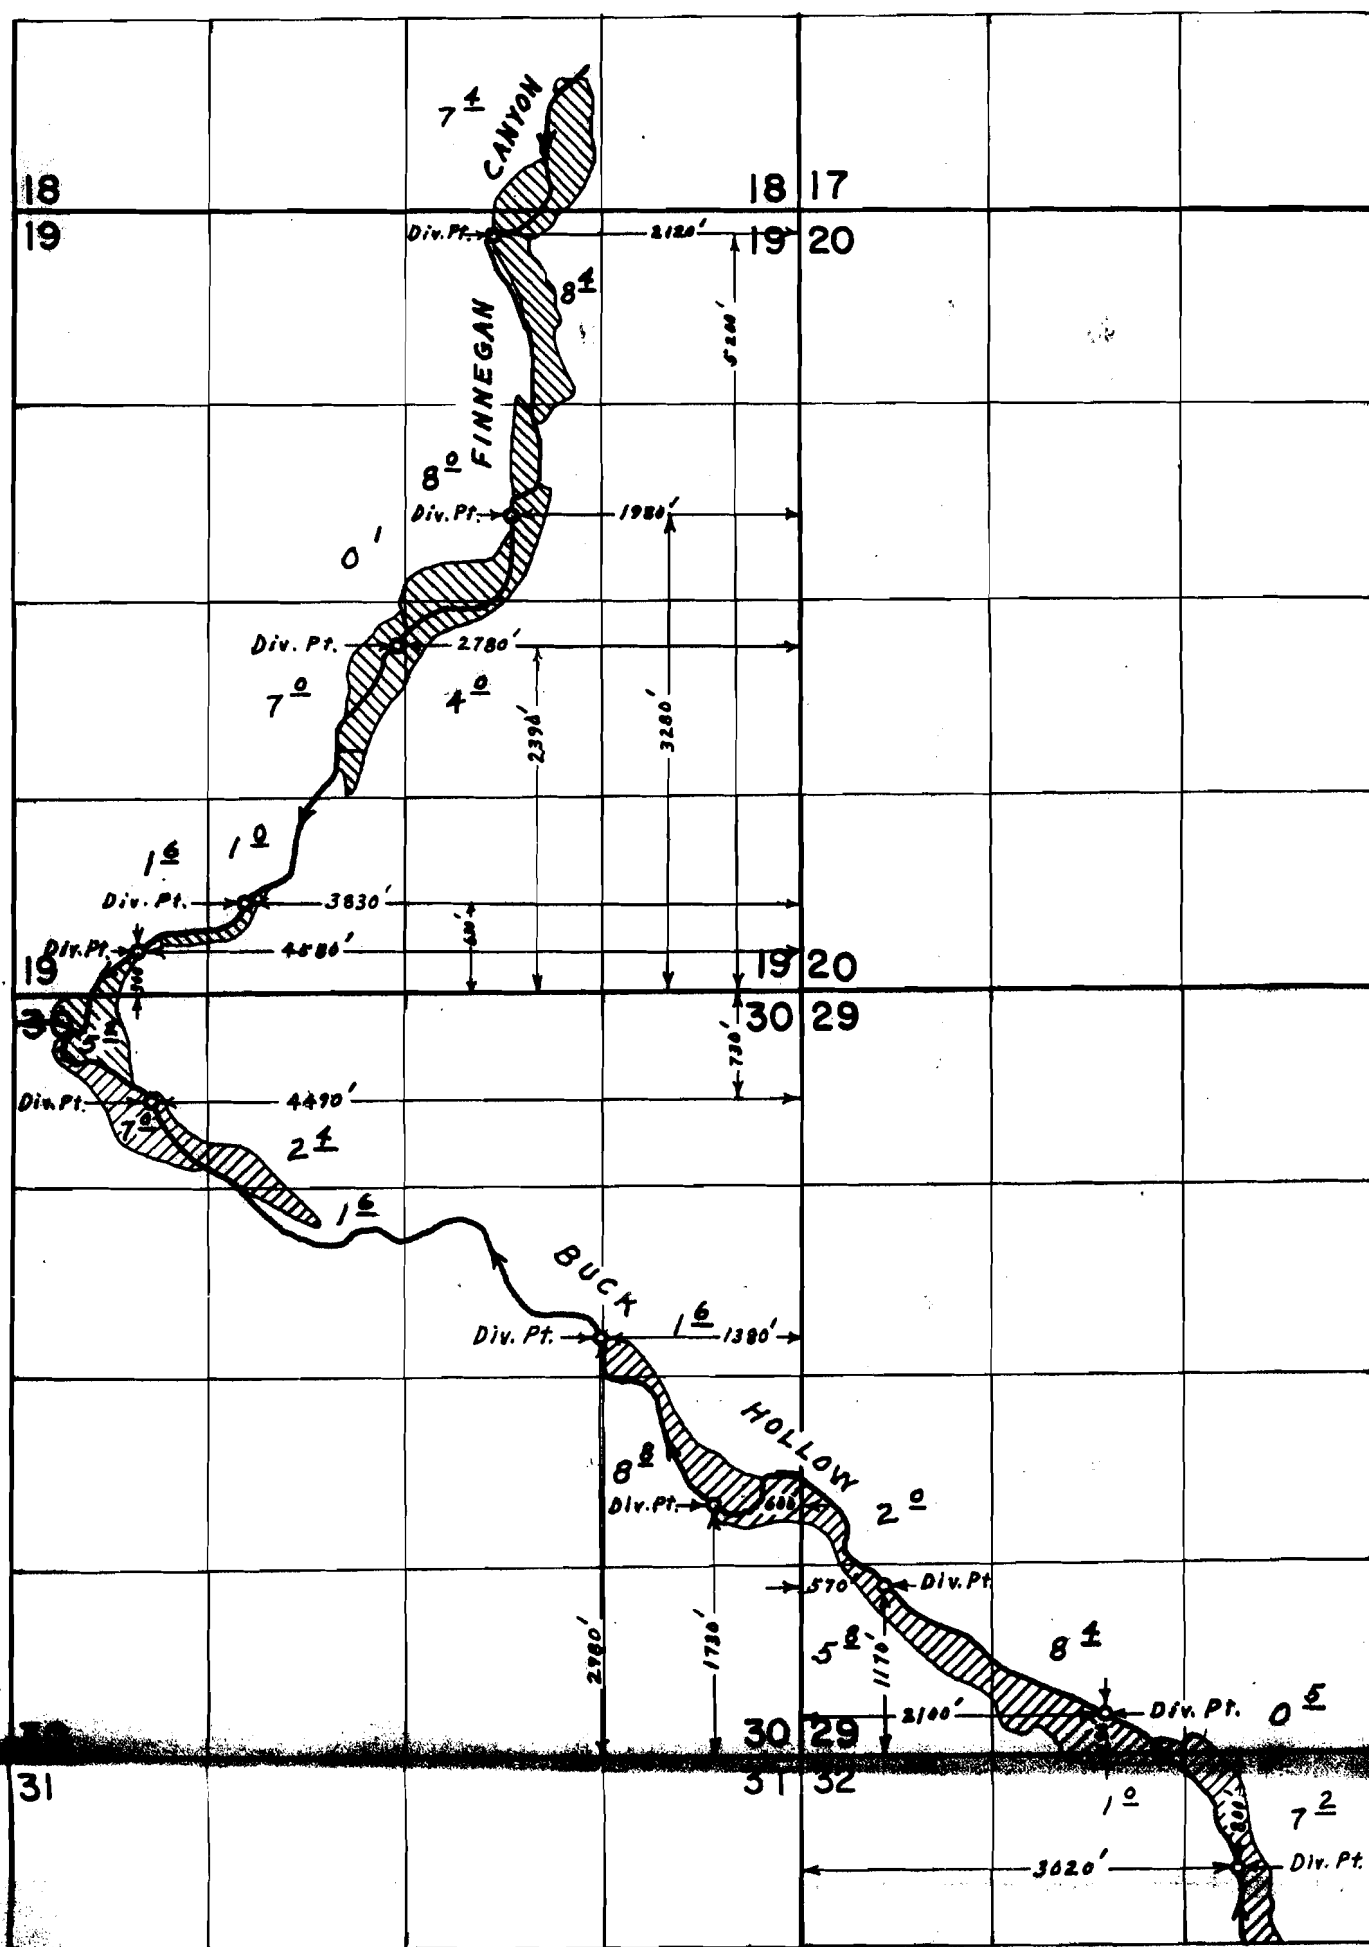

FINAL PROOF SURVEY

UNDER

Application No. 11171 Permit No. 33/48 33/49

IN NAME OF

ESTATE OF JOE BIBBY

Surveyed April 2, 1971, by L. E. Gould