


T. 4 S. R. 16 E. W. M.

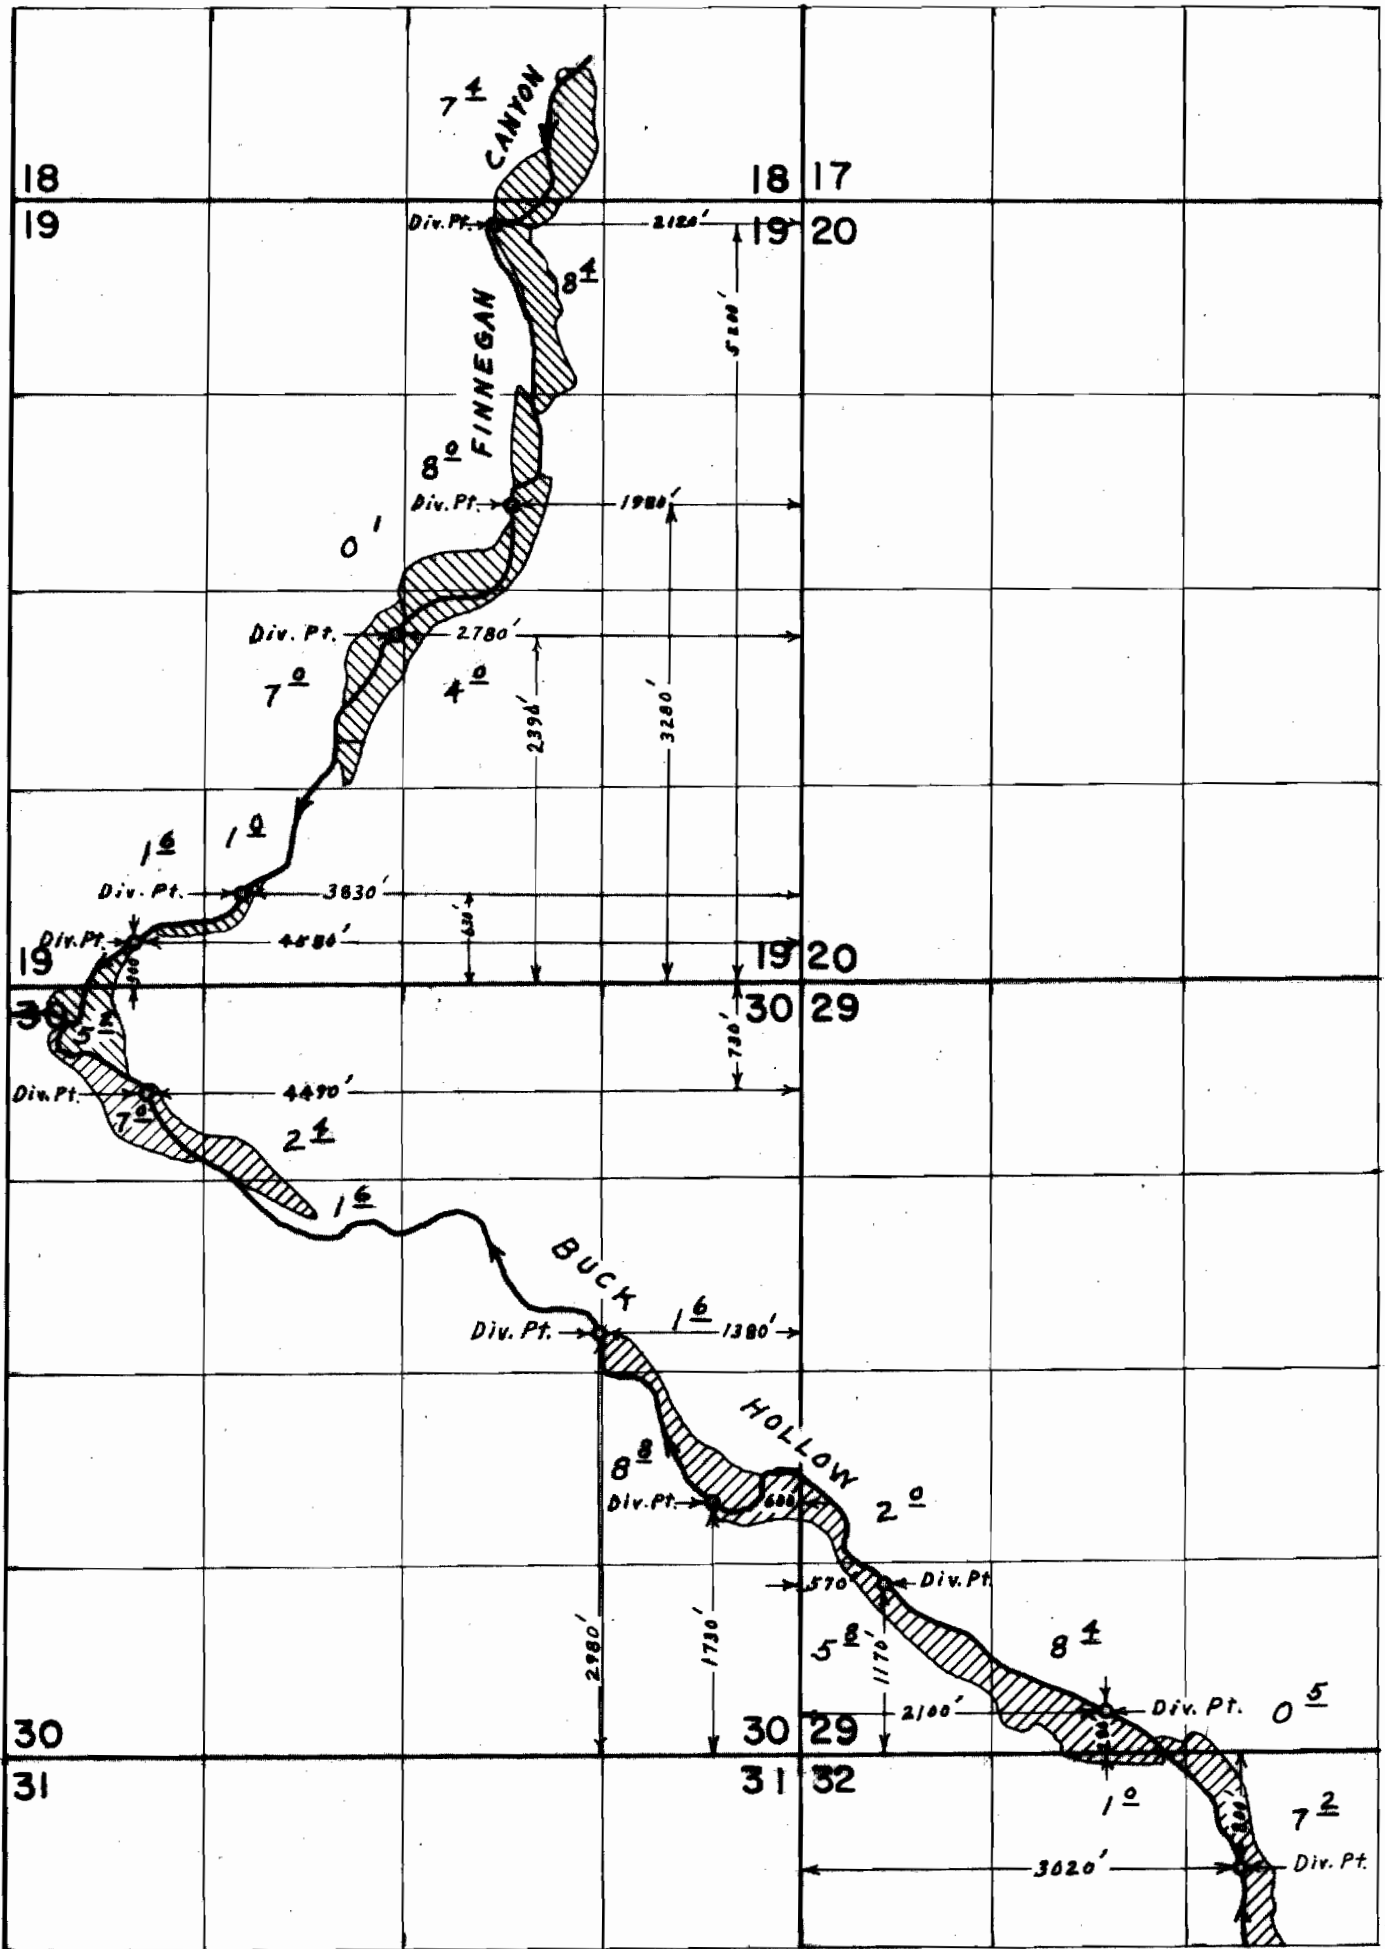

FINAL PROOF SURVEY

UNDER

Application No. ~~44374~~ <sup>44374</sup> Permit No. ~~33/48~~ <sup>33/48</sup>

IN NAME OF

ESTATE OF JOE BIBBY

Surveyed April 2, 1974, by L. E. Gould